FILED

Date: 2/21/2008 By: SC

This survey consists of:

Map:

Narrative:

Corner Rpt: 67/25-14

DOUGLAS COUNTY SURVEYOR

GOVERNMENT CORNER RESTORATION FORM

Township 26 S Range 3 W Sec. 31 County DOUGLAS

State OR Date 2/14/08 No. 200100

Corner Designation

31	32
6	5

Condition Report Only

Not Found

✓ Renewed

Unrecorded

Surveyed In

Referenced Out

Previous Renewals 1950, 1957

Monument(s) Found: (Condition and Source)

3 1/4" DIA BRASS CAP, MARKINGS BECOMING INDISTINCT, IS FOUND 3" BELOW GROUND. SEE MONUMENT DETAIL.

MONUMENT DETAIL

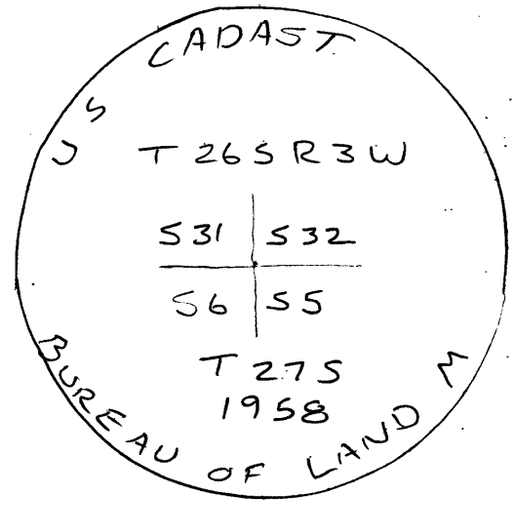

Accessories Found:

11" NOW 32" DIA X 3 FT TALL D. FIR STUMP (CUT ON ANGLE). HEALED LOW BLAZE VISIBLE BEARS S 11 3/4° E, 84.5 FT. (AGREES W/REC) 1958 BT

6" NOW 36" DIA. X 1 FT. TALL D. FIR STUMP, HEALED LOW BLAZE VISIBLE BEARS S 28° W, 150.6 FT. (REC. S 28° W, 151.8 FT) 1958 BT

6" NOW 14" DIA X 6" TALL ROTTEN D. FIR STUMP, PART OF LOWER HEALED BLAZE VISIBLE BEARS N 52 3/4° W, 112.2 FT. (AGREES W/REC) 1958 BT

26" NOW 43" DIA. D. FIR, FULLY HEALED SINGLE BLAZE VISIBLE BEARS N 61 3/4° E, 793.3 FT. - CHECKED BY TRAVERSE, NO LONGER DIRECT LINE OF SIGHT - (AGREES W/REC.) 1958 BT

C.S. File No 67/25-14

RENEWAL

Monument Set (Procedure and Description)

Monument Detail

New Accessories

- 14" DIA. I. CEDAR, DOUBLE BLAZED & SCRIBED "T27S R3W S6 CS BT" BEARS S21½°W, 39.3 FT.
- DOUBLE TRUNK MADRONE, NORTHERLY TRUNK IS 18" DIA. AND IS SCRIBED "T26S R3W S31 CS BT" CENTER OF ROOT CROWN BEARS N 62°W, 16.4 FT.

Sketch of Monument, Acessories, and General Area

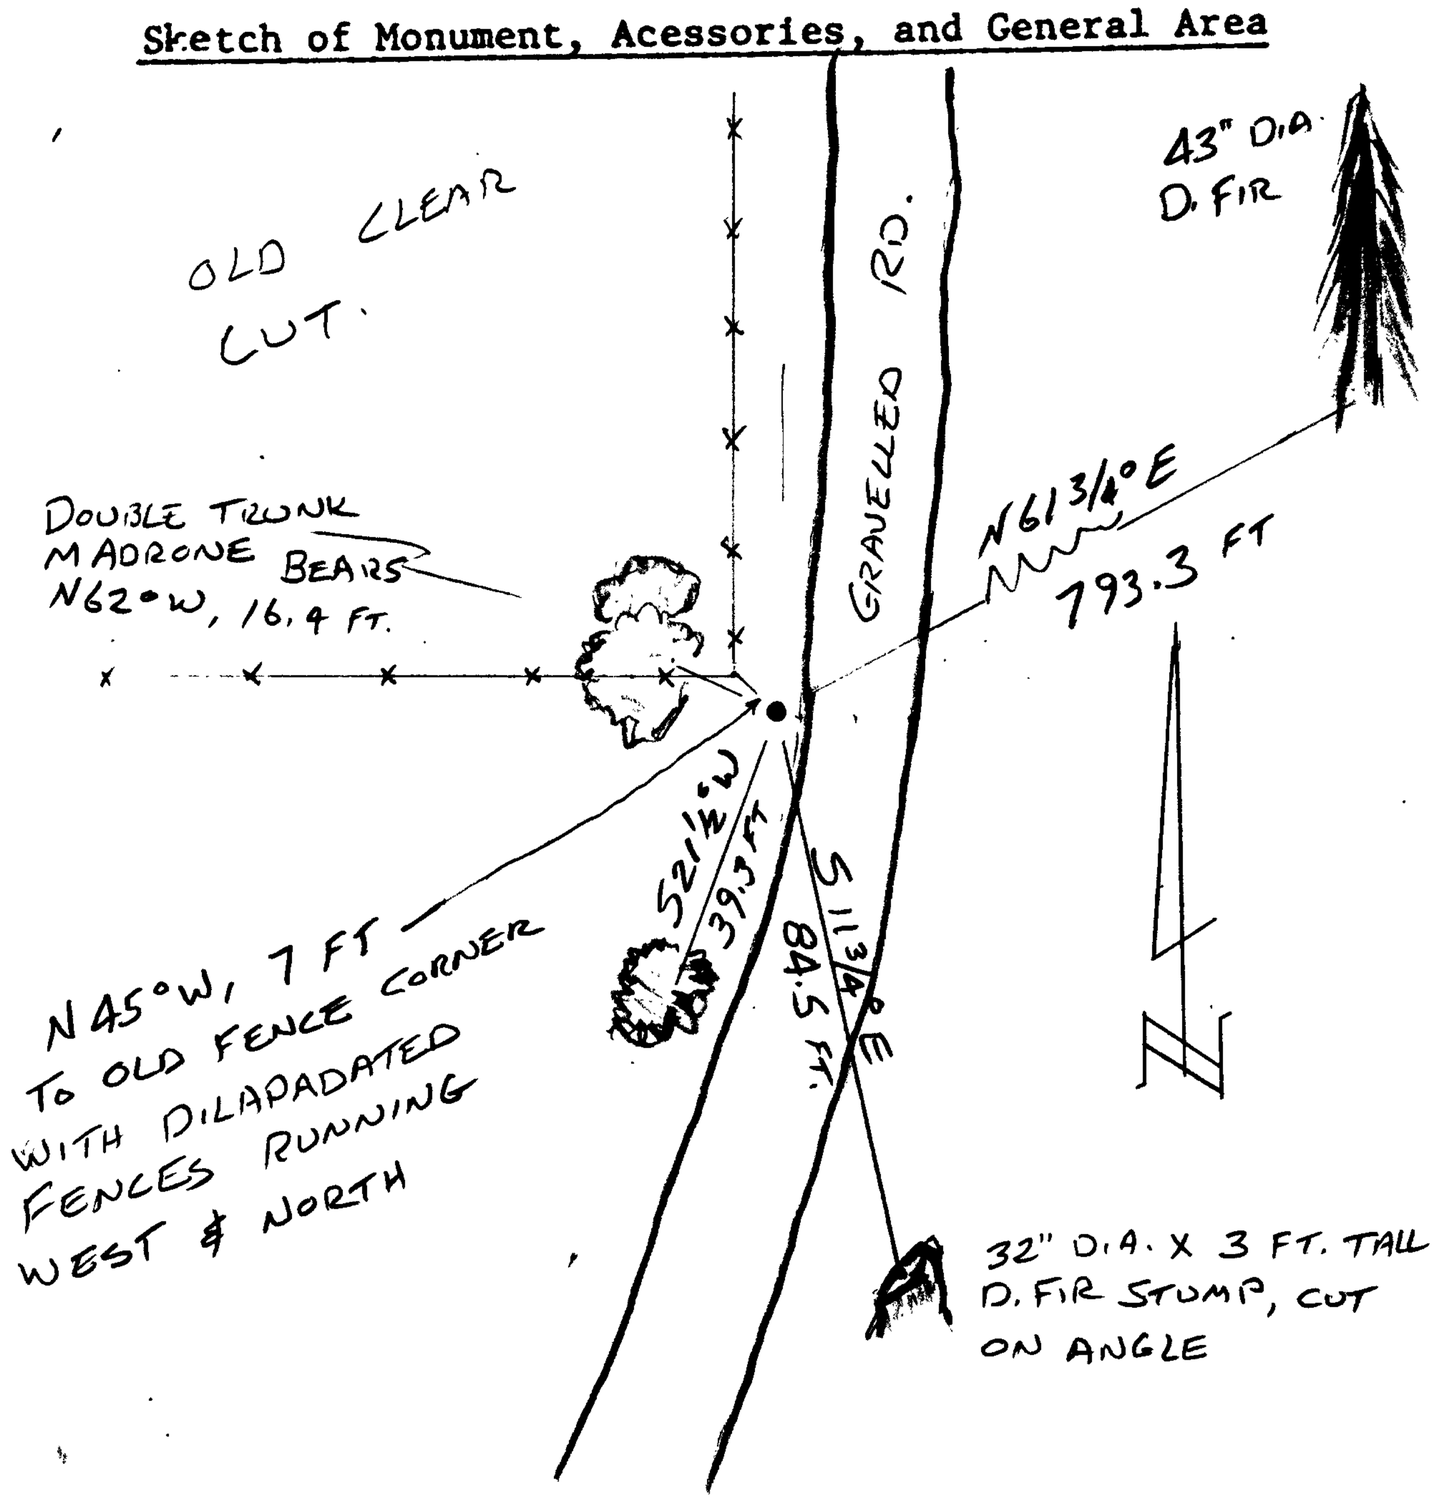

Location & Comments

CORNER LIES 8 FT EAST FROM CENTER OF GRAVELLE RD. OLDER CLEARCUT TO N.W. NEW CLEARCUT IN ALL OTHER QUADRANTS WITH ISOLATED TIMBER PATCHES. NEAR RIDGE TOP.

Comp. Declin. 16¼°E
Agency D.C.S.O.
Party Chief S. FLAUSE
Notekeeper J. PIKE
Witnesses

Address

Surveyor's Seal

REGISTERED PROFESSIONAL LAND SURVEYOR

Randall W. Smith
RENEWAL 6-30-93

OREGON
JULY 25, 1990
RANDALL W. SMITH
2469