FILED

GOVERNMENT CORNER RESTORATION FORM

Date: 3-18-2008 By: JC

This survey consists of:
Map:
Narrative:
Corner Rpt: 67/25-23

DOUGLAS COUNTY SURVEYOR

Township 29S Range 7W Sec. 27 County Douglas

State OR Date MAR. 6, 2008 No. 400240

Corner Designation

1/4

S 28 ⊕ S 27

Condition Report Only
___ Not Found
✓ Renewed
___ Unrecorded
___ Surveyed In
___ Referenced Out

Previous Renewals 1974

MONUMENT DETAIL

Monument(s) Found: (Condition and Source)

B.L.M. BC/IP FOUND LEVEL ON TOP OF GROUND. BRASS CAP IS 3¼" DIA., MARKED AS PER RECORD, I.P. IS 2½" DIA & 29" IN LENGTH INCLUDING B.C.

U.S. DEPT. OF THE INTERIOR
T29S R7W
1/4
S28 | S27
RESET 2008
1974
BUR. OF LAND MANAGEMENT

Accessories Found:

8" NOW 10" DIA x 6 FT TALL D. FIR SNAG, FULLY HEALED SINGLE BLAZE VISIBLE ON ROTTING TRUNK, BEARS N43°E, 20.5 FT. (AGREES W/REC.) 1974 BT.

12" NOW 24" DIA. D. FIR, FULLY HEALED BLAZE VISIBLE BEARS N57½°W, 46.2 FT. (REC. N57½°W 47.5 FT) REC. DIST. FITS WELL AS SLOPE DIST. 1974 BT

¾" I.D. IRON PIPE, CEMENT FILLED. PROJECTS 4" ABOVE GROUND BEARS N136½°W 26.1 FT. (AGREES W/REC.)

C.S. File No 67/25-23

RENEWAL

Monument Set (Procedure and Description)

Monument Detail

POSITION FOR BC/IP WAS DETERMINED BY USING RECORD INFORMATION OF FOUND 3/4" IRON PIPE AND NE BEARING TREE. WE STAMPED "RESET 2008" ABOVE 1974 DATE ON B.C.

New Accessories

17" DIA. D. FIR, DOUBLE BLAZED & SCRIBED "1/4 S28CS BT" BEARS S 78°W, 12.7 FT.

4" DIA D. FIR, DOUBLE BLAZED & SCRIBED "X" ON HIGH BLAZE & "CSBT" ON LOW BLAZE BEARS S 24 3/4°E, 17.8 FT.

Sketch of Monument, Acessories, and General Area

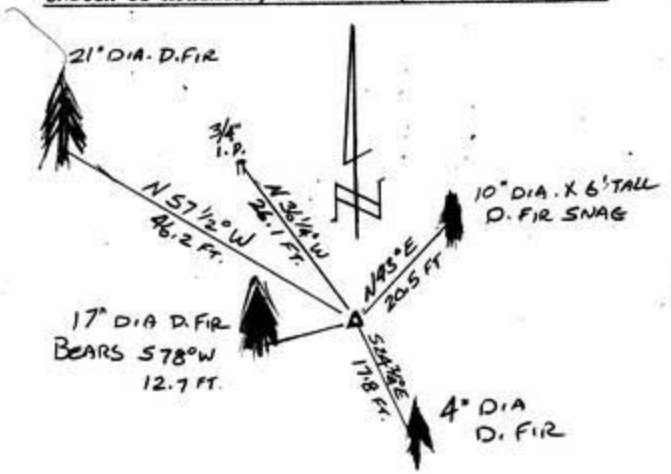

Location & Comments

CORNER LIES ON ON MODERATE WNW FACING SLOPE WITH MATURE TIMBER TO WEST & YOUNG TIMBER TO EAST.

Comp. Declin. 16 1/4° E
Agency O.C.S.D.
Party Chief S. FLAUSE
Notekeeper J. PIKE
Witnesses

Address

Surveyor's Seal

REGISTERED PROFESSIONAL LAND SURVEYOR
6-30-08
OREGON
JULY 25, 1990
RANDALL W. SMITH
2488

LANDING
02.28.2008