FILED

Date: 4-17-2008 By: JC

This survey consists of:

Map:

Narrative:

Corner Rpt: 67/25-24

DOUGLAS COUNTY SURVEYOR

GOVERNMENT CORNER RESTORATION FORM

Township 26 S Range 3W Sec. 9 County DOUGLAS

State OR Date FEB. 28, 2008 No. 340520

Corner Designation

C.S. 1/16 SEC. 9

___ Condition Report Only
___ Not Found
✓ Renewed
___ Unrecorded
___ Surveyed In
___ Referenced Out

Previous Renewals 1924, 1966

Monument(s) Found: (Condition and Source)

G.L.O.

2 1/2" DIA. BRASS CAP MARKED AS SHOWN ON 1" O.D. IRON PIPE, SET FLUSH WITH TOP OF GROUND.

~~NOTE: MARKINGS ON CAP DO NOT INCLUDE LINE DENOTING CENTER OF SECTION WITH "C" AT CAP END.~~

MONUMENT DETAIL

U.S. GENERAL LAND OFFICE SURVEY

S 1/16 S 9

1924

Accessories Found:

- 8" NOW 30" DIA. D. FIR, FULLY HEALED DOUBLE BLAZE BEARS N 2°E, 56.4 FT. (REC. N 6°E, 56.4 FT.)
- POWER POLE "B 20720" BEARS S 38°E, 10.0 FT. (REC. S 34°W, 10.2 FT.)
- SE CORNER OF RESIDENCE AT 21372 N. UMPQUA HWY BEARS S 88 1/4°W, 23.5 FT. REC. N 88°W, 23.5 FT. TO SE CORNER ROYAL COACHMAN CAFE

C.S. File No 67/25-24

RENEWAL

Monument Set (Procedure and Description)

Monument Detail

New Accessories

2½" DIA BRASS CAP ON IRON PIPE AT MEANDER CORNER NORTH BANK OF N. UMPQUA RIVER ON N-S CENTERLINE SECTION 9 BEARS S 0°56' E 188.2 FT. (REC. S 0°56'E, 190.1 FT.)

Sketch of Monument, Acessories, and General Area

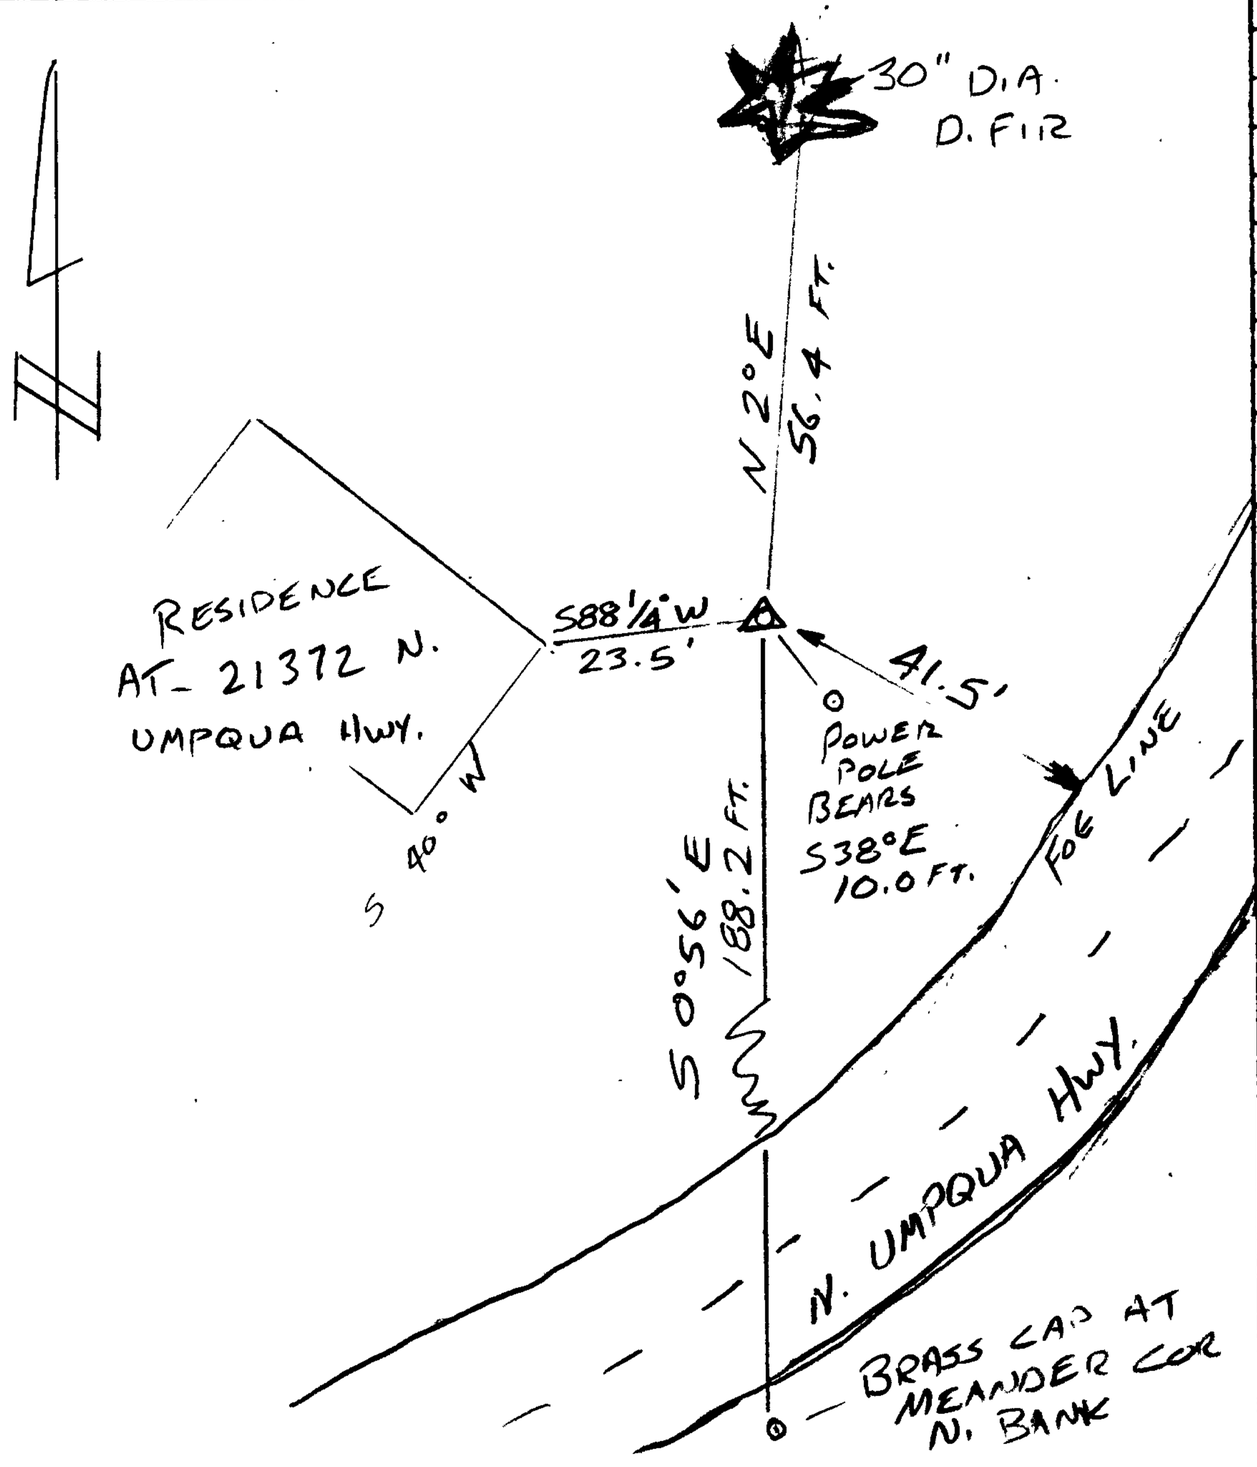

Location & Comments

LIES APROX S 60°E, 41.5 FT FROM FOG LINE ON N. UMPQUA HWY. SEE SKETCH

Comp. Declin. 16¼° E
Agency D.C.S.O.
Party Chief S. FLAUSE
Notekeeper J. PIKE
Witnesses

Address

Surveyor's Seal

REGISTERED PROFESSIONAL LAND SURVEYOR

Randall W. Smith
RENEWAL 6-30-08

OREGON
JULY 25, 1990
RANDALL W. SMITH
2499