FILED
Date: 5/19/2008 By: JC
This survey consists of:
Map:
Narrative:
Corner Rpt: 67/25-48

GOVERNMENT CORNER RESTORATION FORM

Township 28S Range 5W Sec. 30 County DOUGLAS

State OR Date MAY 14, 2008 No. 100240

Corner Designation

WEST 1/4 SEC. 30

DOUGLAS COUNTY SURVEYOR

___ Condition Report Only
___ Not Found
✓ Renewed
___ Unrecorded
___ Surveyed In
___ Referenced Out

Previous Renewals 1961

Monument(s) Found: (Condition and Source)

2 1/2" DIA. BRASS CAP, MARKED AS PER RECORD, PROJECTS 18" ABOVE GROUND. FIRMLY SET.

MONUMENT DETAIL

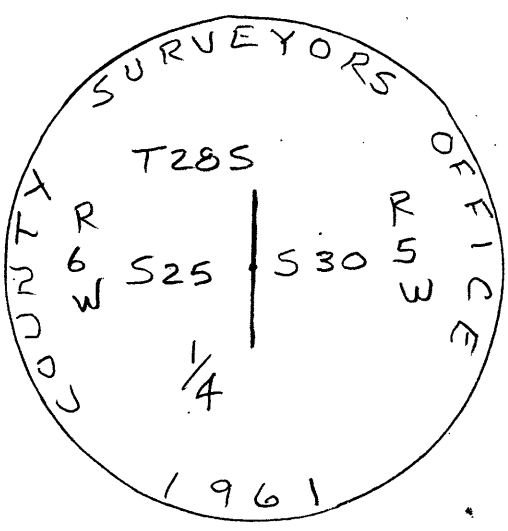

Accessories Found:

- ORIG 14" NOW 29" DIA W. OAK SNAG 20 FT. TALL APPROX. HEALED BLAZE VISIBLE, BEARS N 64° E, 17.2 FT. (AGREES W/REC) O.B.T.
- 15" NOW 15" DIA. X 8" TALL ROTTED W. OAK STUMP, NO MARKS VISIBLE BEAR S 63° W, 50.2 FT. (AGREES W/REC) 1961 BT
- ORIG 17" NOW 26" DIA. X 1 FT. TALL ROTTED W. OAK STUMP, NO MARKS VISIBLE BEARS N 62° W, 23.8 FT. (AGREES W/REC.) O.B.T.

C.S. File No 67/25-48

RENEWAL

Monument Set (Procedure and Description)

Monument Detail

New Accessories

- 9" DIA. MADRONE, DOUBLE BLAZED & SCRIBED "1/4 S30 CS BT" BEARS S 4 1/2° E, 52.0 FT.
- 9" DIA. W. OAK, DOUBLE BLAZED & SCRIBED "1/4 S30 CS BT" BEARS N 79° E, 73.8 FT.
- 5 FT. TALL ALUM FENCE POST BEARS NORTH, 1 FT.
- NO OTHER SUITABLE TREES WITHIN REASONABLE DIST.

Sketch of Monument, Acessories, and General Area

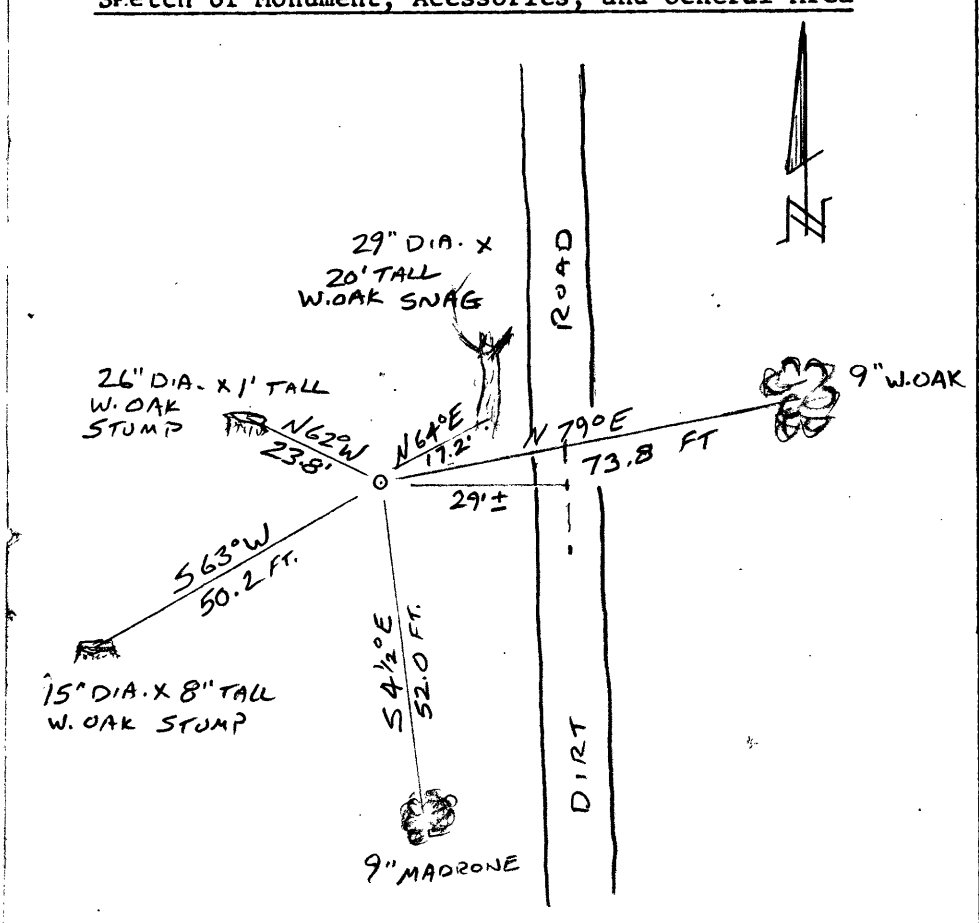

Location & Comments

CENTER OF DIRT RD. BEARS EAST 29' ±.
CORNER LIES ON MODERATE NORTH FACING SLOPE.

Comp. Declin. 16 1/4° E
Agency D.C.S.O.
Party Chief S. FLAUSE
Notekeeper J. PIKE
Witnesses

Address

Surveyor's Seal

REGISTERED PROFESSIONAL LAND SURVEYOR
Expires 6-30-09
OREGON
JULY 25, 1990
RANDALL W. SMITH
2469