GOVERNMENT CORNER RESTORATION FORM

FILED
Date 7/2/2008 By: JC
DOUGLAS COUNTY SURVEYOR

Township 27 Range 5 Sec. 24 County DOUGLAS

State OREGON Date 6/25/08 No. 700340

This survey consists of:
Map:
Narrative:
Corner Rpt: 67/25-59

Corner Designation

1/4

24 | 19

___ Condition Report Only
___ Not Found
X Renewed
___ Unrecorded
___ Surveyed In
___ Referenced Out

Previous Renewals

Monument(s) Found: (Condition and Source)

2 1/2 IN DIA BRASS CAP (MARKED AS SHOWN) 10 IN BELOW GROUND
NOTE: BRASS CAP NOT DATED

MONUMENT DETAIL

COUNTY SURVEYORS OFFICE
1/4 COR
24 | 19

Accessories Found:

CAST IRON WATER MAIN ACCESS COVER NOW PAVED OVER CENTER OF INDENT BEARS: S62 1/2° W 9.3 FT (AGREES W/ RECORD)

COPCO POWER POLE # B6122 NOW LABELED "PACIFICORP" # 249401 BEARS S 27° W 41.4 FT (AGREES W/ REC.)

ALL OTHER ACCESSORIES GONE

C.S. File No 67/25-59

RENEWAL

Monument Detail

Monument Set (Procedure and Description)

New Accessories

DOUBLE TRUNK ASH, SOUTHERLY TRUNK IS 30" DIA AND IS SCRIBED "1/4 S 19 CS" BT CENTER OF ROOT CROWN BEARS N 6½° E 128.5 FT

NO SUITABLE ACCESSORIES IN SE QUADRANT

"PACIFICORP" POWER POLE # 249500 11 IN DIA BEARS N 44¾° W 29.1 FT

Sketch of Monument, Acessories, and General Area

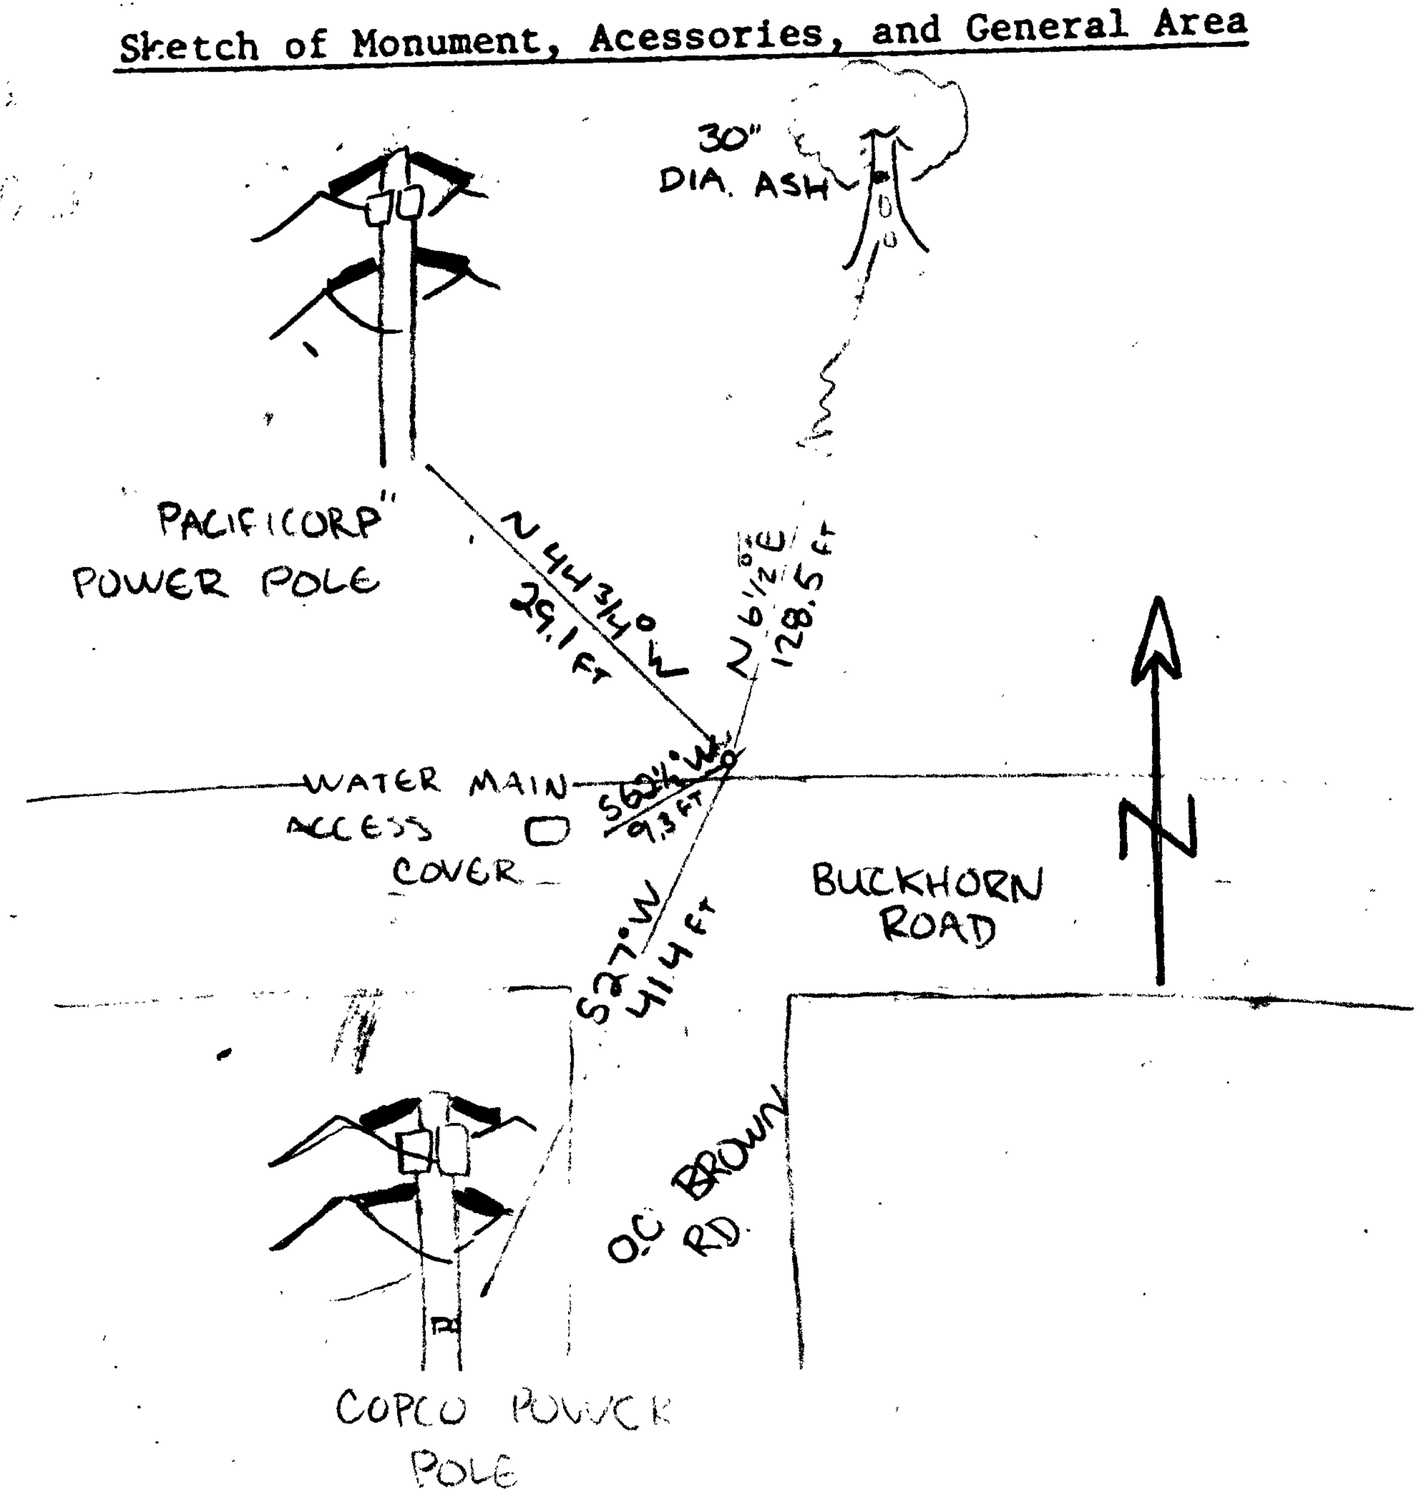


Location & Comments

COR LIES APPROX. 3 FT NORTHERLY OF INTERSECTION OF O.C BROWN RD. AND BUCKHORN RD.

Comp. Declin. 16¼° E

Agency D.C.S.O

Party Chief JOHN PIKE

Notekeeper KODY INDA

Witnesses

Address

Surveyor's Seal

REGISTERED PROFESSIONAL LAND SURVEYOR

Randall W. Smith
Renewal 6-30-2010

OREGON
JULY 25, 1990
RANDALL W. SMITH
2489