GOVERNMENT CORNER RESTORATION FORM

FILED
Date: 7-16-08 By: K
This survey consists of:
Map:
Narrative:
Corner Rpt: CS 67/25-62

DOUGLAS COUNTY
SURVEYOR

Township 28 S Range 6 W Sec. 7 County DOUGLAS

State OR Date JUNE 26, 2008 No. 040050

Corner Designation

INT.: "L" DLC 40

Condition Report Only
Not Found
✓ Renewed
Unrecorded
Surveyed In
Referenced Out

Previous Renewals

MONUMENT DETAIL

Monument(s) Found: (Condition and Source)

UNMARKED STONE FOUND AS PER NOV. 2002 D.C.S.O. VISIT

3/4" I.R. PROJECTS 2" ABOVE GROUND ON EAST SIDE OF STONE. APPEARS TO BE DIRECTLY UNDER HIGHEST POINT OF STONE. (SEE 2002 DCSO RENEWAL)

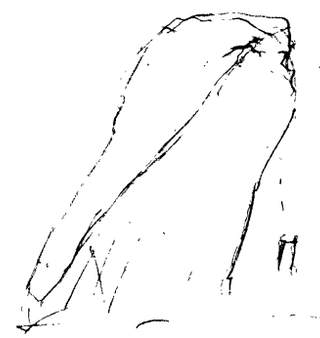

Accessories Found:

NONE

C.S. File No 67/25-62

RENEWAL

Monument Set (Procedure and Description)

Monument Detail

New Accessories

POWER POLE 2A101L 11" IN DIA. BEARS N 44° W 31.6 FT

18 IN DIA. W. OAK DOUBLE BLAZED AND SCRIBED "DLC 40 CS BT" BEARS S 60° W, 4.2 FT. DIA. MEASURED AT TOP OF BLAZE

NW CORNER OF STEEL SIDED SHOP (MEASURES 40' BY 59') BEARS S 33½° E. 20.0 FT

Sketch of Monument, Acessories, and General Area

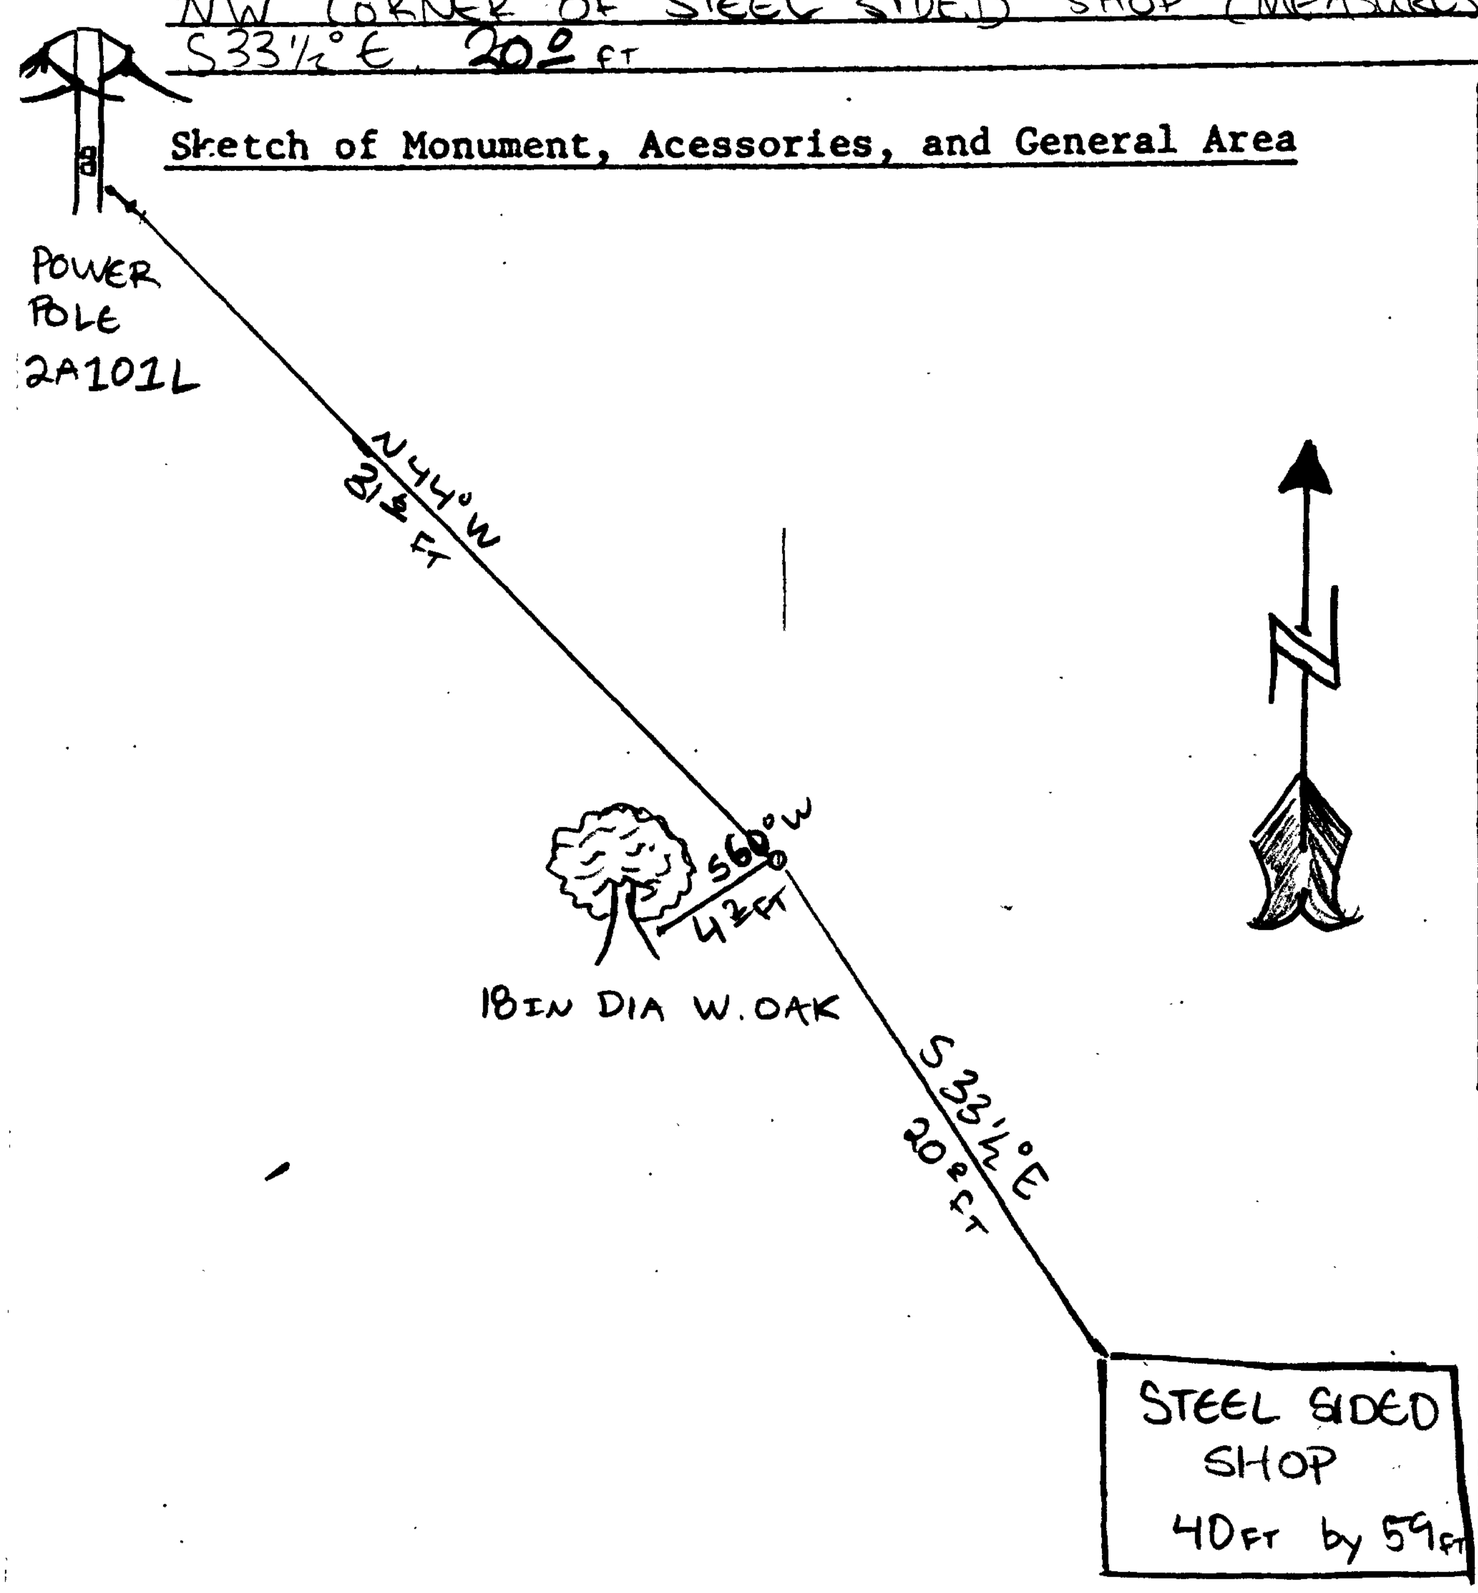

Location & Comments

STONE LIES APROX. 6" SOUTH OF E-W FENCE LINE

Comp. Declin. 16¼° E
Agency D.C. SO
Party Chief JOHN PIKE
Notekeeper KODY INDA
Witnesses

Address

Surveyor's Seal

REGISTERED PROFESSIONAL LAND SURVEYOR

Randall W. Smith
Expires 6-30-2010

OREGON
JULY 25, 1990
RANDALL W. SMITH
2468