FILED

GOVERNMENT CORNER RESTORATION FORM

Date: 1-15-2009 By: X

Township 29 S Range 5W Sec. 6 County DOUGLAS

This survey consists of:
Map:
Narrative:
Corner Rpt: 67/28-5

State OR Date 1-13-2009 No. 100600

Corner Designation

51	56
512	57

DOUGLAS COUNTY SURVEYOR

____Condition Report Only
____Not Found
____Renewed
____Unrecorded
____Surveyed In
____Referenced Out

Previous Renewals 1962

Monument(s) Found: (Condition and Source)

2 1/2" BRASS CAP ON A 1 1/2 O.D. IRON PIPE PROTRUDING 13" OUT OF GROUND. (1962)

MONUMENT DETAIL

COUNTY SURVEYORS OFFICE.

T 29 S

R 6 W	51	56	R 5 W
	512	57	

1962

Accessories Found:

ORIG NW BT NOW DOWN, ALL OTHERS ARE GONE.

1962 SW BT NOW GONE

10" NOW 10" DIA. 6' HIGH ROTTED W. OAK SNAG A ROTTED BLAZE BEARS S69°E, 18.0 FT 1962

11" NOW 20" DIA. W. OAK WITH A FULLY HEALED DOUBLE BLAZE BEARS N56°E, 74.5 FT / (REC N58°E, 74.5 FT) 1962

C.S. File No 67/285

RENEWAL

Monument Set (Procedure and Description)

N/A

Monument Detail

N/A

New Accessories

DOUBLE TRUNKED W. OAK DOUBLE BLAZED AND SCRIBED "T29S R6W S12 C5 BT" ON 18" DIA. EASTERLY TRUNK BEARS S7°W, 72.7 FT TO CENTER OF ROOT CROWN. 5" PINE DOUBLE BLAZED AND SCRIBED "X BT" BEARS S74°W, 45.4 FT. DOUBLE TRUNKED CEDAR DOUBLE BLAZED AND SCRIBED "X BT" ON 5" DIA. EASTERLY TRUNK BEARS N65°W, 45.7 FT

Sketch of Monument, Acessories, and General Area

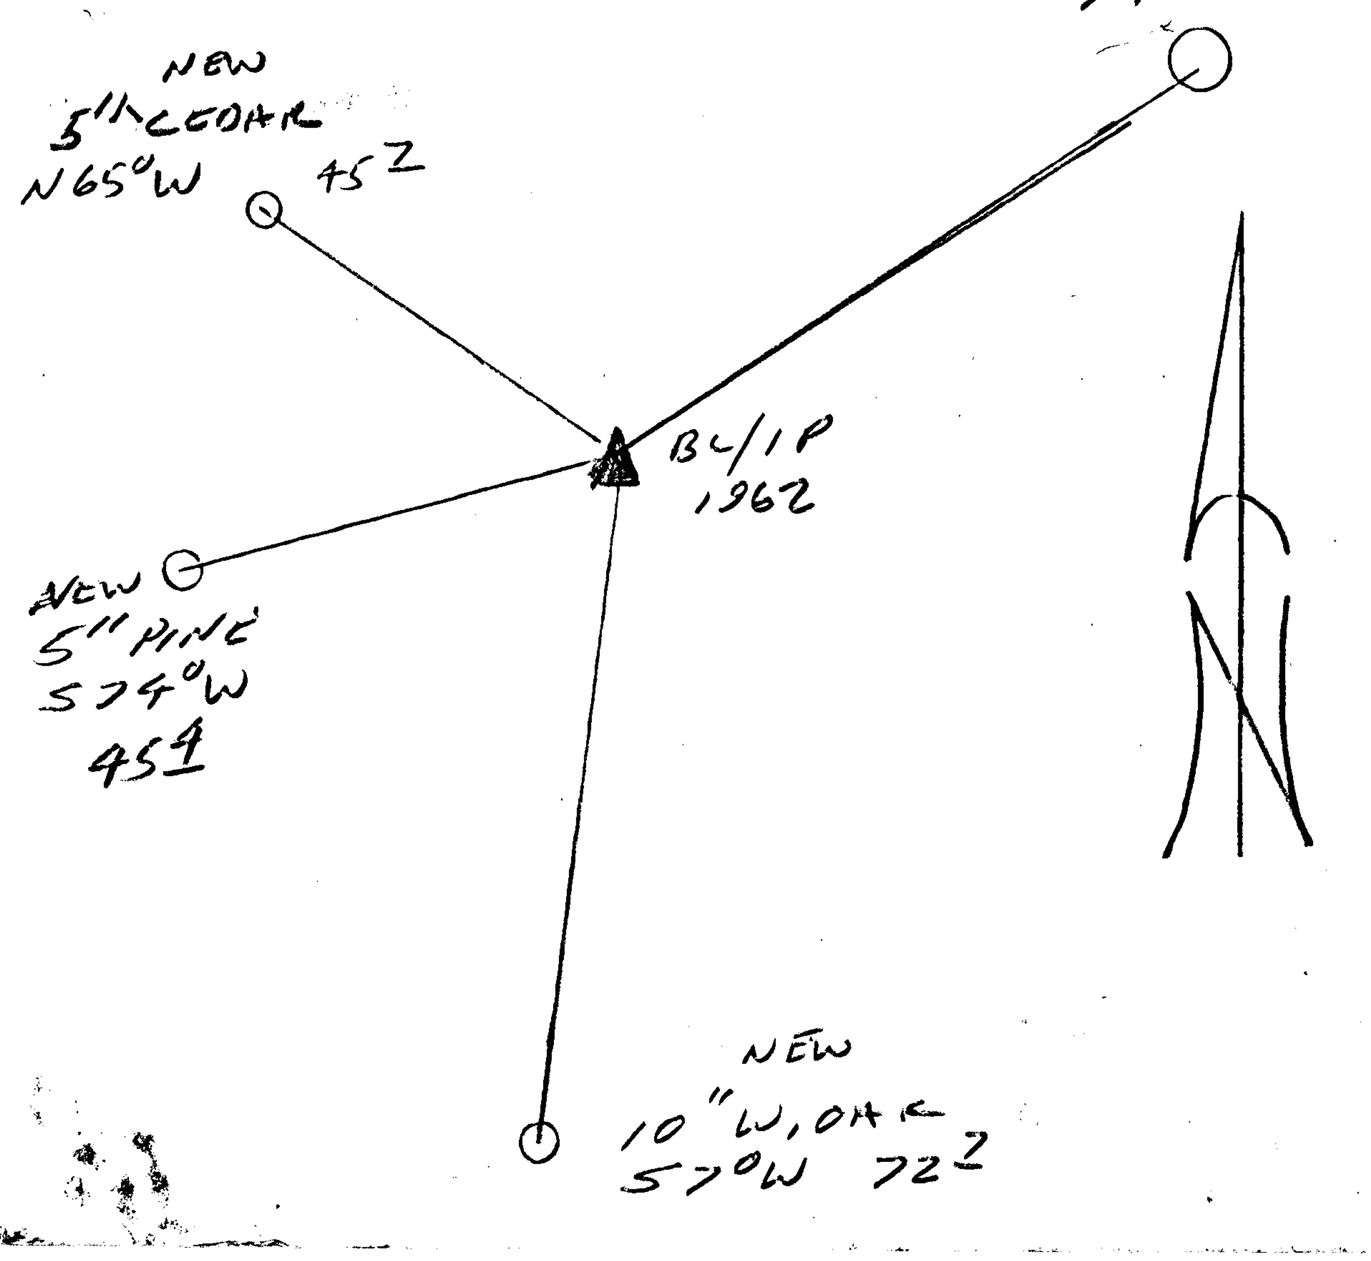

Location & Comments

Comp. Declin. 16½°E
Agency DCSC
Party Chief RANDY SMITH
Notekeeper RANDY SMITH
Witnesses STEVE FLAUSE

Address

Surveyor's Seal

REGISTERED PROFESSIONAL LAND SURVEYOR

OREGON
JULY 25, 1990
RANDALL W. SMITH
2469

RENEWAL 6-30-2010