R

FILED
Date: 4/1/2009 By: JC
This survey consists of:
Map:
Narrative:
Corner Rpt: 67/28-24

DOUGLAS COUNTY SURVEYOR

GOVERNMENT CORNER RESTORATION FORM

Township 29S Range 3W Sec. 13 County DOUGLAS

State OR Date 3-31-09 No. 640400

Corner Designation

13
1/4
14

____Condition Report Only
____Not Found
✓ Renewed
____Unrecorded
____Surveyed In
____Referenced Out

MONUMENT DETAIL

Previous Renewals

Monument(s) Found: (Condition and Source)

FD 1976 BLM BC/LP
PROTRUDING 11" OUT OF GROUND

Accessories Found:

BEARINGS + DIST'S NOT CHECKED
1976 BLM D.FIR BT'S
NW BT NOW BURNT AND ROTTED HIGH CUT STUMP
SE BT NOW HIGH CUT STUMP WITH HEALED BLAZE

1987 BLM D.FIR BT
SW BT NOW HIGH CUT ROTTING STUMP NO MARKS VISIBLE

1999 M134-8 D.FIR BT'S
S78°E BT NOW HIGH CUT STUMP WITH SCRIBING VISIBLE ON AN UNHEALED BLAZE
S32°E BT NOT SEEN OR LOOKED FOR

C.S. File No 67/28-24

RENEWAL

Monument Set (Procedure and Description)

N/A

Monument Detail

N/A

New Accessories BRG TAKEN WITH A HAND COMPASS

5"DIA D.FIR DOUBLE BLAZED AND SCRIBED "Y4 S13 BT"
BEARS N 53°W, 9.3 FT

7"DIA D.FIR DOUBLE BLAZED AND SCRIBE "Y4 S13 CS BT"
BEARS N 72°E, 15.3 FT

Sketch of Monument, Acessories, and General Area

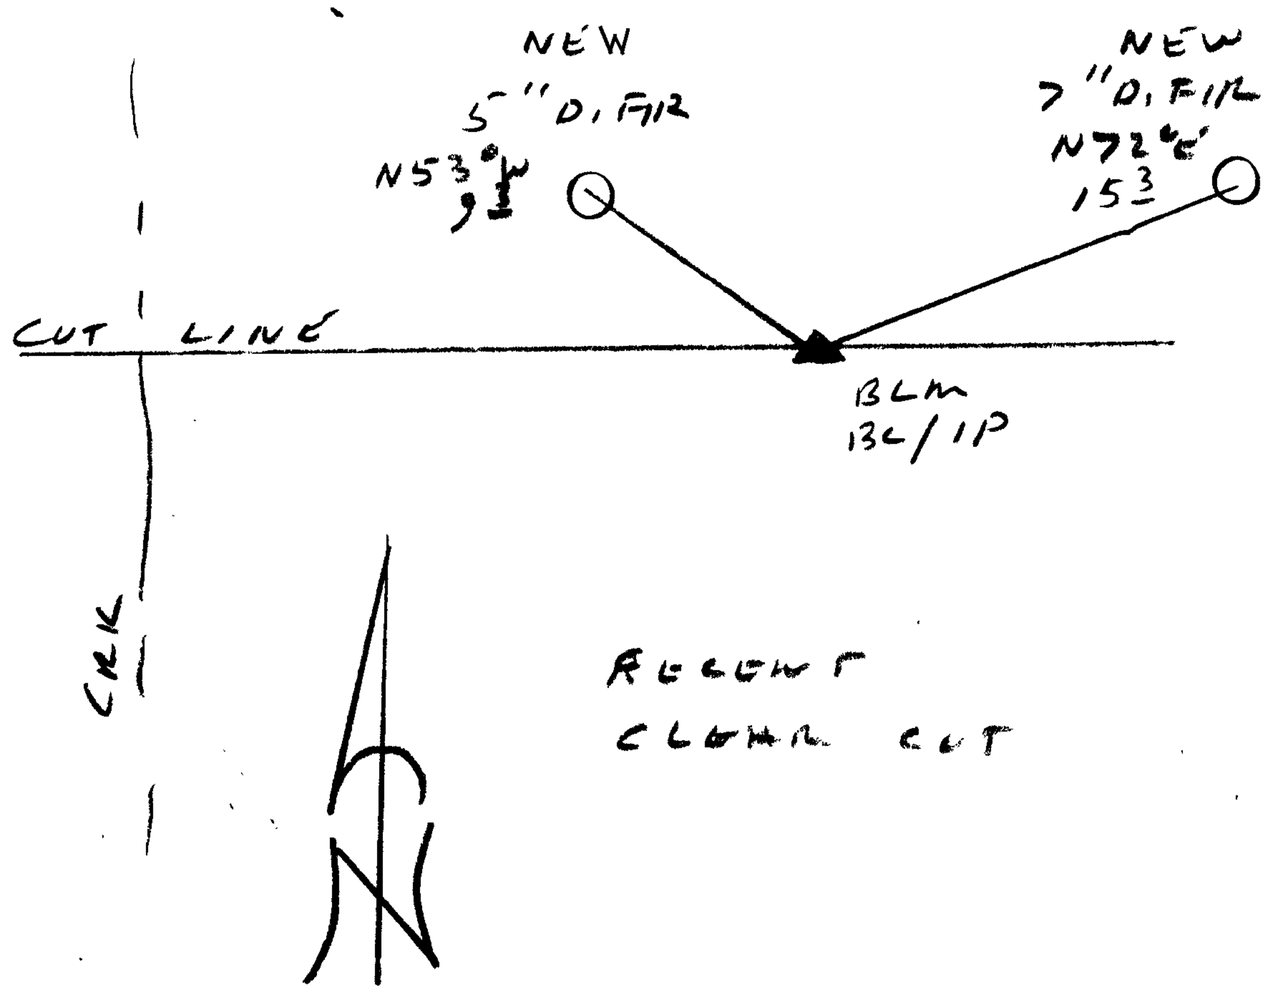

Location & Comments

CORNER LIES ON
AN E-W CUT LINE

AT THE REQUEST OF RON
RICE A SEARCH WAS
MADE FOR ORIG. BT'S
NOTHING FOUND

Comp. Declin. 16 1/2°E
Agency BLM
Party Chief RANDY SMITH
Notekeeper RANDY SMITH
Witnesses STEVE FLUSE

Address

Surveyor's Seal

REGISTERED
PROFESSIONAL
LAND SURVEYOR

OREGON
JULY 25, 1990
RANDALL W. SMITH
2488