R

FILED

Date: 4/6/2011 By: JC

This survey consists of:

Map:

Narrative:

Corner Rpt: CS 67/33-19

DOUGLAS COUNTY SURVEYOR

GOVERNMENT CORNER RESTORATION FORM

Township 29S Range 06W Sec. 29 County DOUGLAS

State OREGON Date MARCH 1, 2011 No. 240200

Corner Designation

1/4 29/32

____ Condition Report Only
____ Not Found
✓ Renewed
____ Unrecorded
____ Surveyed In
____ Referenced Out

Previous Renewals 1956, 1962

Monument(s) Found: (Condition and Source)

NO EVIDENCE OF 1956 AXLE MONUMENT FOUND.
FROM THE 1962 RENEWAL A 2 1/2 INCH DIAMETER BRASS CAP (MARKED AS AT RIGHT) ON A 1 1/2 INCH I.D. IRON PIPE IS FIRMLY SET AND PROTRUDES APPROX. 1 FOOT ABOVE GROUND.

MONUMENT DETAIL

COUNTY SURVEYORS OFFICE

1/4 S29 ~~S28~~ / S32

1962

Accessories Found:

EVIDENCE OF ONE ORIGINAL 1904 BEARING TREE IS FOUND.
A CEDAR 7" DIA., NOW A VERY ROTTED 20 INCH DIAMETER 1 FOOT TALL CEDAR STUMP WITH NO MARKS BEARS S55°W, 26± FEET DISTANT (AS PER RECORD).

EVIDENCE OF 3 RENEWAL B.T.'S FROM 1956:
AN 11" CHIP. NOW A 22 INCH D.B.H. CHINQUAPIN WITH A FULLY HEALED DOUBLE BLAZE; BEARS S48 1/2°E, 15± FEET DISTANT (RECORD S51°E, 15± FT, THIS IS POSSIBLY A FACE MEASUREMENT).
A 7" LAUREL NOW A 2 FOOT TALL 12 INCH DIAMETER MADRONE STUMP WITH A FULLY HEALED LOW BLAZE (WE DO NOT OPEN); BEARS S26°W, 32± FEET DISTANT (AS PER RECORD).
A 40" FIR NOW A 48 INCH D.B.H. DOUGLAS FIR WITH A FULLY HEALED SINGLE BLAZE; BEARS N 78°E, 60± FEET DISTANT (AS PER RECORD).

C.S. File No 67/33-19

RENEWAL

Monument Set (Procedure and Description)

N/A

Monument Detail

N/A

New Accessories

A 22 INCH D.B.H. GRAND FIR SCRIBED "1/4 S29 CS" "BT" ON A DOUBLE BLAZE; BEARS N 17 1/2° W, 42± FEET DISTANT.
A 15 INCH D.B.H. RED CEDAR SCRIBED "1/4 S32 CS" "BT" ON A DOUBLE BLAZE; BEARS S 1 1/2° E, 48± FEET DISTANT.
A 1/2 INCH DIAMETER REBAR WITH A 2 INCH ALUMINUM CAP (MARKED AS AT RIGHT BELOW) IS FIRMLY SET PROTRUDING 6 INCHES ABOVE GROUND AND BEARS N 77° E, 56± FEET DISTANT.

Sketch of Monument, Acessories, and General Area

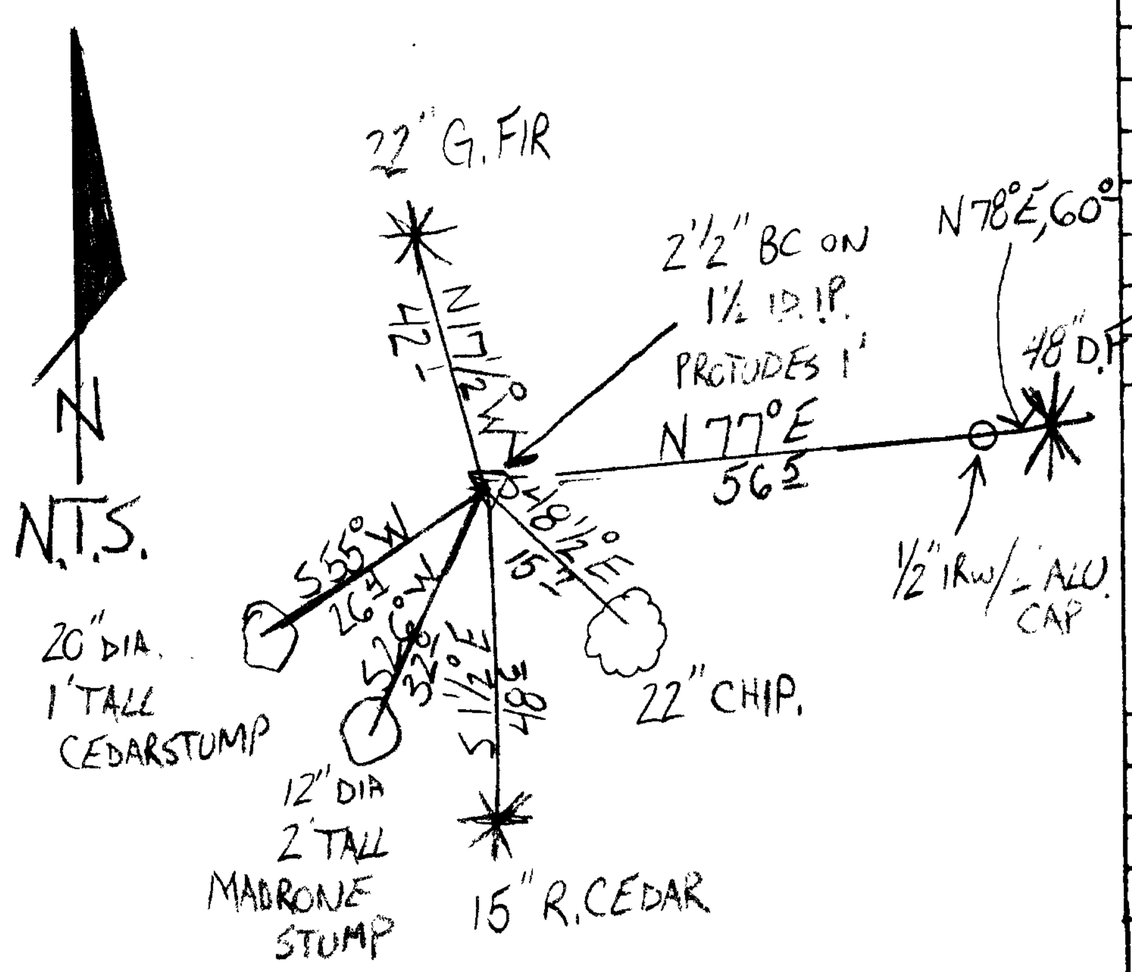

Location & Comments

2010 OR-10-287
3500 BLM

MONUMENT IS ON FLAT FORESTED BENCH WEST AND NORTH APPROX. 100 FEET FROM A DIRT ROAD.

Comp. Declin. 15 3/4° E
Agency DCSO
Party Chief STEPHEN JOHN FLAUSE
Notekeeper Stephen John Flause
Witnesses
MIKE S. KOCH, GARRETT A. MCGRAW

Address

Surveyor's Seal

REGISTERED
PROFESSIONAL
LAND SURVEYOR

Randall W. Smith
Renewal 6-30-2012

OREGON
JULY 25, 1990
RANDALL W. SMITH
2488