R

GOVERNMENT CORNER RESTORATION FORM

Date: 4-6-2011 By: JC

Township 30S Range 06W Sec. 9 County DOUGLAS

This survey consists of:
Map:
Narrative:
Corner Rpt. CS 67/33-24

State OREGON Date MARCH 22, 2011 No. 400540

DOUGLAS COUNTY SURVEYOR

Corner Designation

1/4

S9 | S10

___ Condition Report Only
___ Not Found
✓ Renewed
___ Unrecorded
___ Surveyed In
___ Referenced Out

Previous Renewals 1967

Monument(s) Found: (Condition and Source)

THE 1967 RENEWAL BC IS FOUND.
A 3 1/2 INCH DIAMETER BRASS CAP (MARKED AS AT RIGHT) ON A 2 1/2 O.D. IRON PIPE IS FIRMLY SET AND PROTRUDES 9 INCHES ABOVE GROUND. MONUMENT IS SET ON N.E. EDGE OF FENCE CORNER POST WITH FENCES RUNNING NORTH AND EAST.

MONUMENT DETAIL

U.S. DEPT. OF THE INTERIOR
1/4
S9 S10
T 30S R 6W
1967
BUR. OF LAND MANAGEMENT

Accessories Found:

EVIDENCE OF TWO ORIGINAL BEARING TREES.
A RED FIR 8" DIA., NOW A 3 FOOT TALL, 32 INCH DIAMETER, ROTTED FIR STUMP WITH NO REMAINING MARKINGS; BEARS S60°W, 17 9/10 FEET DISTANT (RECORD S60°W, 16 5/10 FEET IS A GOOD FACE MEASUREMENT).
A PINE 24" DIA., NOW A 2 FOOT TALL, APPROX. 16 INCH DIAMETER, ROTTED PINE STUMP WITH NO REMAINING MARKINGS; BEARS N38°E, 37 3/10 FEET (RECORD N40°E 36 3/10 FEET, DISTANCE IS A GOOD FACE MEASUREMENT).

EVIDENCE OF ONE UNRECORDED AND TWO RENEWAL B.T.S FROM 1967.
A FIR SNAG 20" DIA. NOW 1 1/2 FOOT TALL, APPROX 12+ INCH DIAMETER VERY ROTTEN FIR STUMP WITH NO REMAINING MARKS; BEARS S27°W, 37 9/10 FEET DISTANT (RECORD S27°W, 38 9/10 FEET)
A DOUGLAS FIR 15" DIA. NOW A 25 INCH D.B.H. WITH A FULLY HEALED SINGLE BLAZE; BEARS S41 1/2°E, 106 3/10 FEET DISTANT (RECORD S40°E, 106 3/10 FEET).
A WHITE FIR 10" DIA., NOW A 24 INCH D.B.H. GRAND FIR (LOWLAND WHITE FIR) WITH A FULLY HEALED SINGLE BLAZE; BEARS S73°W, 31 3/10 DISTANT (AS PER RECORD).

C.S. File No 67/33-24

RENEWAL

Monument Set (Procedure and Description)

N/A

Monument Detail

N/A

New Accessories

A 14 INCH D.B.H. INCENSE CEDAR SCRIBED "1/4 S10 CS" "BT" ON A DOUBLE BLAZE; BEARS N53 1/2°E, 53 2/ FEET DISTANT.

A 19 INCH D.B.H. DOUGLAS FIR (WHICH IS DOUBLE TRUNKED ABOVE 12 FEET) SCRIBED "1/4 S9 CS" "BT" ON A DOUBLE BLAZE; BEARS N28 1/2°W, 21 3/ FEET DISTANT.

Sketch of Monument, Acessories, and General Area

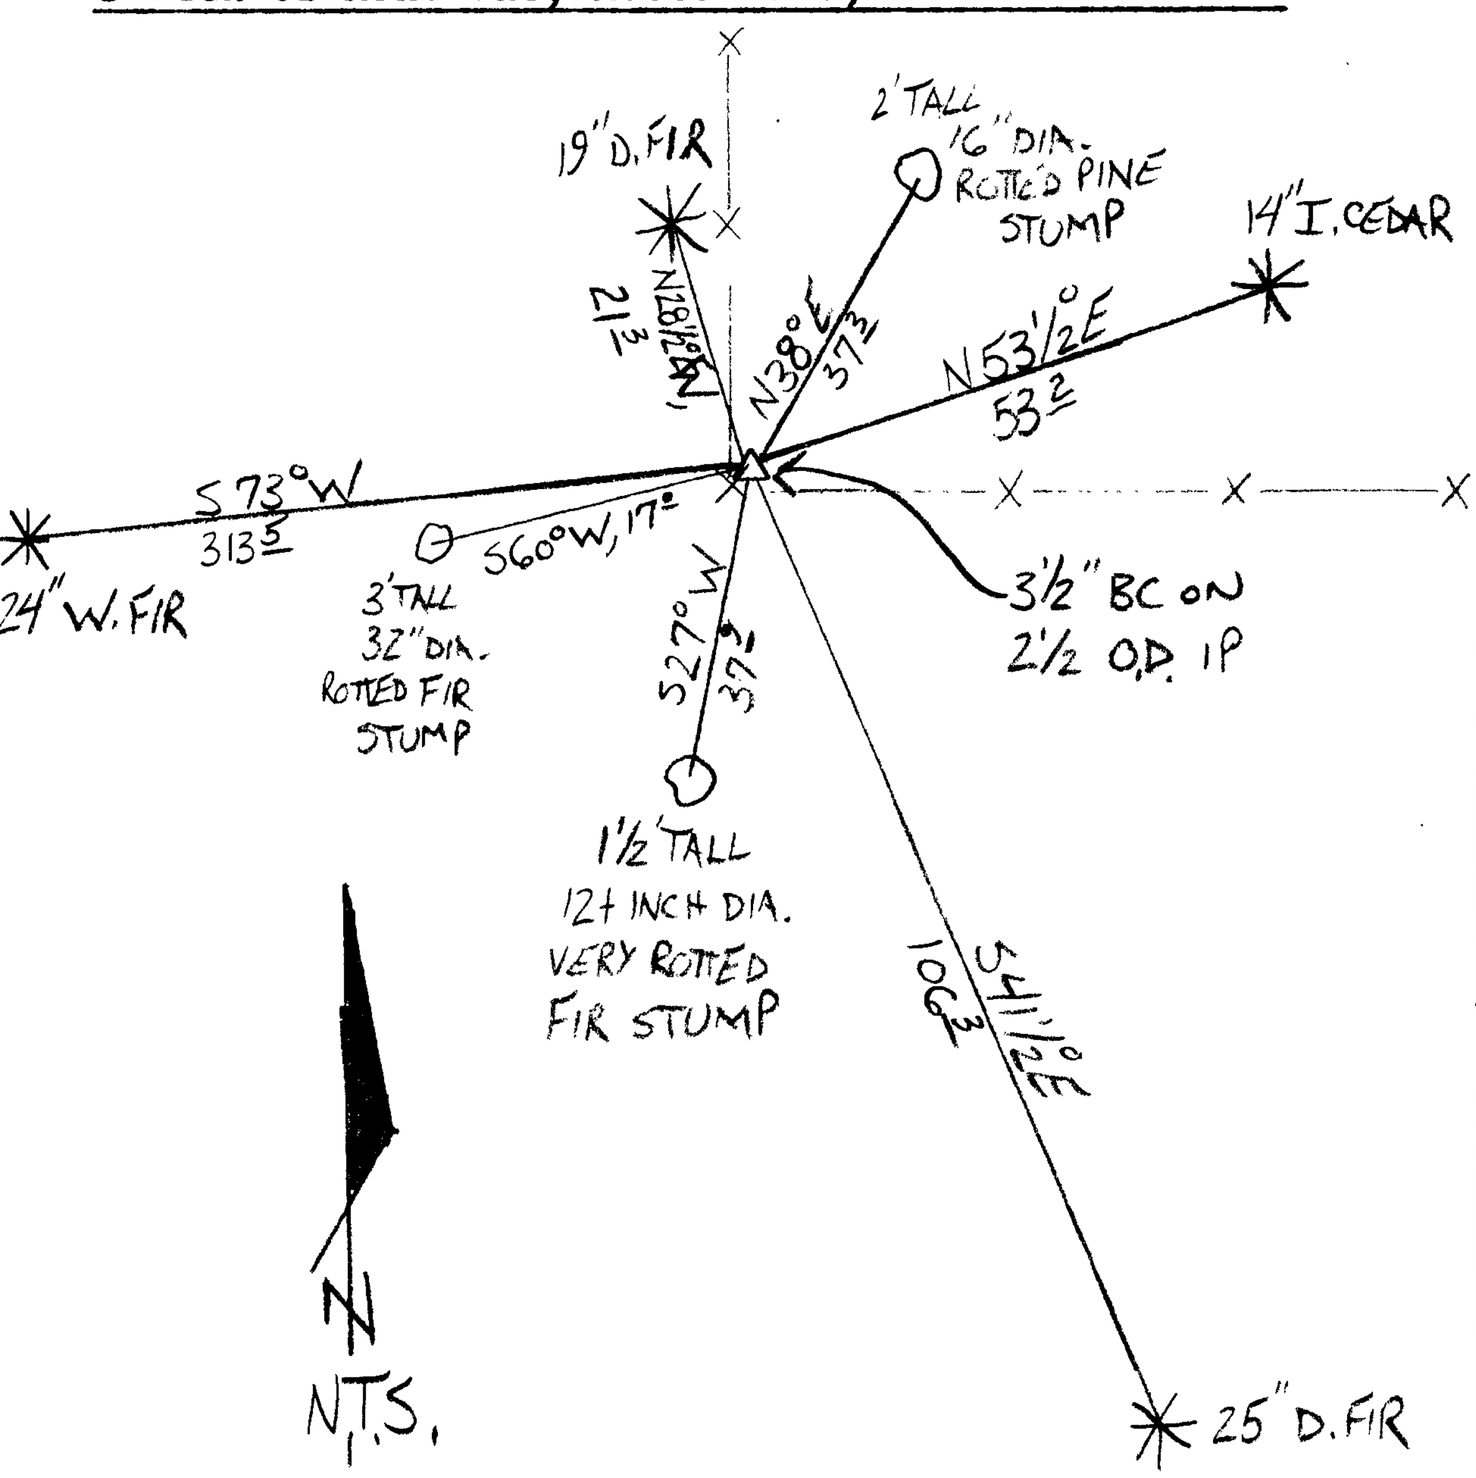

Location & Comments

CORNER IS LOCATED ON VERY GENTLE SW SLOPE IN OLD REPROD. MIXED FOREST OF FIR, CEDAR, MADRONE AND PINE.

Comp. Declin. 15 3/4°E
Agency NCSO
Party Chief STEPHEN JOHN FLAUSE
Notekeeper Stephen John Flause
Witnesses MIKE S. KOCH
GARRETT A. MCGRAW

Address

Surveyor's Seal

REGISTERED PROFESSIONAL LAND SURVEYOR

Expiration 6-30-2012

OREGON
JULY 25, 1990
RANDALL W. SMITH
2468