

GOVERNMENT CORNER RESTORATION FORM
DOUGLAS COUNTY SURVEYOR

FILED
Date: 9-11-2018

By: SC

Corner Form: _____

Field Notes: CS 67/45-5

DOUGLAS COUNTY SURVEYOR

DATE: August, 2018

- Condition Report Only
- Not Found
- Renewed
- Unrecorded
- Surveyed In
- Referenced Out

TOWNSHIP 30S RANGE 03W SECTION 6 & 7 PLSS/GCDB No. 30-03-100600

CORNER DESIGNATION: SW CORNER OF 6 & NW CORNER OF 7


CORNER HISTORY, PREVIOUS RENEWALS OR SURVEYS:

- See DCSO survey and renewal records for PLSS: 30-03-100600.

MONUMENT DETAIL

MONUMENT FOUND (CONDITION AND SOURCE):

- A 1" i.d. iron pipe, firmly set, projecting 10" above ground by B. Irving and J. Byron in 1953 per C.S. File 45/219 with a 2 1/2" diam. brass cap marked as per detail:
- The 1889 corner stone is partially buried along the SE edge of the BCIP.

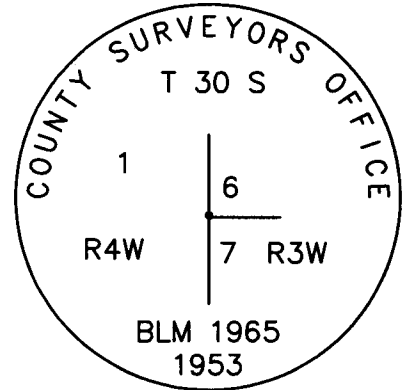

ACCESSORIES FOUND (CONDITION, SOURCE & RECORD):

A Bearing Tree by W. Thiel 1889:

- The severely rotted remnants of a 30" diam. fir stump bears S. 88° E., 21.8 ft.

And a Bearing Tree by B. Irving & J. Byron in 1953:

- A 29" diam. x 2 1/2 ft. tall rotted fir stump bears S. 50° W., 31.7 ft. with a healed blaze.

And Bearing Trees by R. Smith & S. Flause in 1984:

- 11" diam. ash bears S. 38° E., 12.8 ft. with a healed double blaze.
- 9" diam. double trunked maple bears N. 73° E., 13.2 ft. with a fully healed double blaze.

NEW ACCESSORIES:

- 7" diam. maple bears S. 8 1/2° W., 8.1 ft. scribed "T30S R4W S1" & "CS BT" on a double blaze.
- 10" diam. ash bears N. 87 1/2° W., 34.1 FT. scribed "T30S R4W S1" & "CS BT" on a double blaze.

LOCATION & COMMENTS:

The corner falls 90 ft. East of the driveway to 2765 Days Creek Rd. and 50 ft. South of the centerline of Days Creek C. Rd. #34.

GEODETIC COORDINATES

LATITUDE:
LONGITUDE:
ELLIPSOID HEIGHT:
DATUM: NAD 83
SOURCE:

COMPASS DECLINATION: 15° E.

AGENCY: DCSO
PARTY CHIEF: S. J. FLAUSE
WITNESSES: JEFF A. LORSUNG
NOTES: ATTACHED

REGISTERED
PROFESSIONAL
LAND SURVEYOR

Kristian O. Degroot

OREGON
JULY 17, 1981
KRISTIAN O. DEGROOT
1941

CS 67/45-5

RENEWAL DATE: 12-31-2019