GOVERNMENT CORNER RESTORATION FORM

FILED
Date: 11/23/2021 By: x
This survey consists of:
Map:
Narrative: CS
Corner Rpt: 67/51-16
DOUGLAS COUNTY SURVEYOR

TOWNSHIP 22S RANGE 8W SEC. 4 PLSS # 351600

DOUGLAS COUNTY OREGON DATE 9-23-21

Corner Designation

mc wc

___ Condition Report
___ Not Found
___ Renewed
___ Unrecorded
___ Surveyed In

Previous Renewals DCSO

Monument(s) Found: (Condition and Source)

DCSO 1962 CS 52/14-44
Roberts 1997 M-124-44 &
CS 65/12-5 A-B
DCSO 1997 CS 64/74-6
2 3/8" BRASS CAP ON 1 3/8" OD
IRON Pipe protrudes 4"
Above ground
Hibbs 2020 M 176-92

MONUMENT DETAIL

Douglas County SURVEYORS
B01
WEST 20 FT
TO W/C MC
1997
OFFICE

Accessories Found

1962 DCSO BEARING Tree
38" D. Fir North 11.0 FT Fully Healed Double
BLAZE will be cut down Soon

C.S. File 67/51-16

RENEWAL

Monument Set (Procedure and Description)

MONUMENT DETAIL

New Accessories

16" Maple N 81½ E 26.0 From 5/8 x 60" W/C To MC Scribe WC MC 59 CS BT

Sketch of Monument, Accessories, and General Area

See Attached Sheet.

Location & Comments

Comp. Decline 15° E
Agency DCSO
Party Chief J F/AUSE
Note keeper
Witnesses J LORSUNG

REGISTERED
PROFESSIONAL
LAND SURVEYOR

Ronald A Quimby

OREGON
JULY 14, 1978
RONALD A. QUIMBY
1654

Expires: 12/31/2022

CS 67/51-14

T22S, R8W, 351600

9/23/21

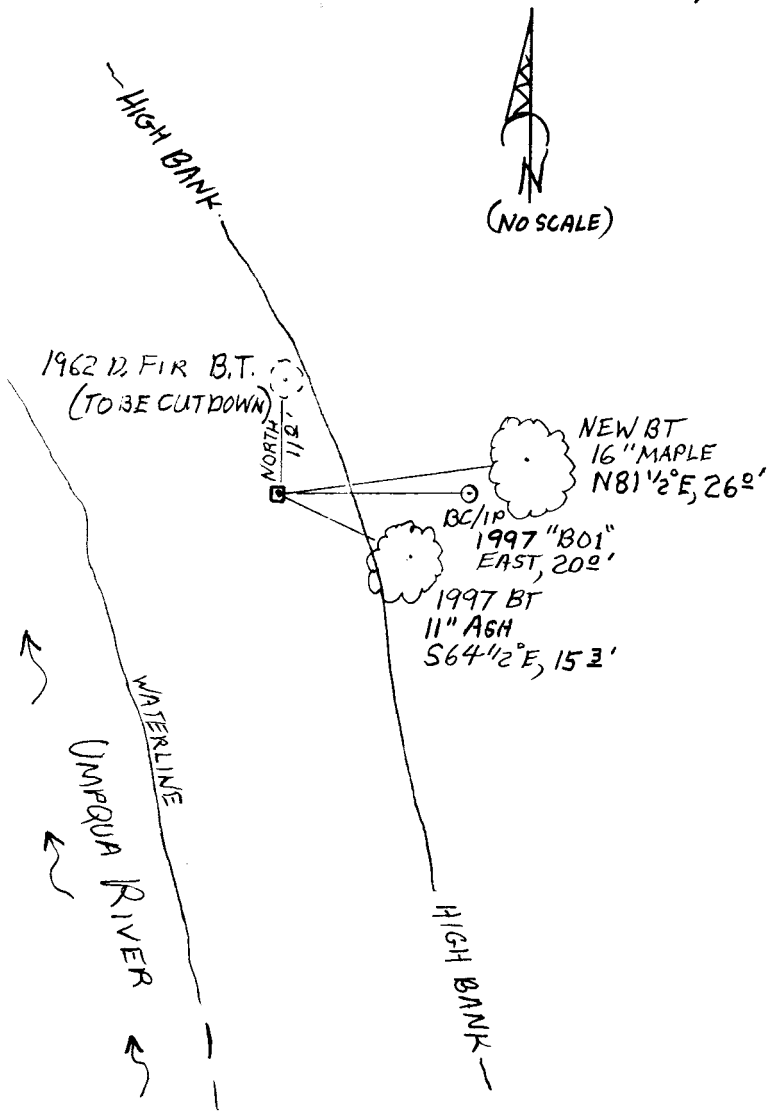

CS 67/51-16

No MMGPS 9/23/21

TOWNSHIP 22 RANGE 08 POINT IDENTIFIER # 351600

PRIMARY CORNER DESCRIPTION M. C. So. bdy. Sec. 4 (WC)

Alias 877820 Description M.C. Right bank Umpqua River
Alias 050030 Description Pt. on W. bdy. DLC #50
Alias Description
Alias Description

GLO survey by Gordon and Gardner, under Contract #52 dated Feb. 17, 1855 (DCSO records Vol. 4 Page(s) 1575-76)

Set meander post on right bank of Umpqua, from which
A W.Oak 4" dia., bears N.48°E., 34 lks. dist.
An Ash 15" dia., bears S.4°W., 25 lks. dist.

Douglas Co. Surveyors Office - Milo E. Godfrey, Deputy - M. Stone & V. Tracy, crew - Dec. 20, 1962 - C.S. File 52/14-44

Found - W.Oak now 24", N.48°E., 22.4 ft., cut open, found axe marks at least 60 years old where tree was opened previously. Also found small portion of straight scribe marks on piece of old face.
The center of a clump of young Ash trees growing in a circle, bears S.4°W., 16.5 ft.
This location also fits tie from NW corner DLC #50. Corner location too close to river.
SET WIT. COR. 20 FT. EAST OF M.C.
Set Brass cap at cor. mkd: County Surveyors Office
T 22 S R 8 W
WC 1855 WC \S 4
\S 9
20 ft. W. to M.C.
1962
New BTs 18" D.Fir, North, 11.0 ft. mkd. W.C. M.C. S4 CS BT
10" Ash S.47°W., 26.8 ft. mkd. W.C. MC S9 CS BT.
This is a renewal of Gordon and Gardner's Meander Corner, 1855 survey. Byar's section line (1881 survey) is approx. 200 ft. South.

FD. OK - Les Roberts - M 124-44 & CS 65/12-5 A&B - 2-10-97

Douglas County Surveyors Office - Randall Smith & Stephen Flause - Mar. 17, 1997 - C.S. 64/74-6

Found - BC/IP from 1962 DCSO renewal not found area now below high bank.
Bearings and distance taken from W.C. Position
FALLEN DOWN RIVERBANK NO POSITION 4" now 27" dia. W.Oak, with a previously opened blaze facing southwest no scribing visible, bears N.12½°W., 15.4' (Note this agrees with a calculated position using original and 1962 bearing & distance). 1855 OBT
38" WILL BE CUT DOWN SOON 18" now 26" dia. D.Fir, with a fully healed double blaze, bears North 11' (agree with rec.) 1962
No other BTs Found
(Cont. Next Page)

CS 67/51-16

TOWNSHIP 22 RANGE 08 POINT IDENTIFIER # 351600

PRIMARY CORNER DESCRIPTION M. C. So. bdy. Sec. 4

Alias 877820 Description M.C. Right bank Umpqua River
Alias 050030 Description Pt. on W. bdy. DLC #50
Alias Description
Alias Description

Set- 5/8"x5' long iron rod with Alum. cap marked W.C. M.C. is set at a position determined by BT's for witness corner. Protrudes 6" above ground. — FND BURIED NOW PROJ. 6"
2⅜" dia. Brass cap on a 1⅜" O.D. by 32" long iron pipe is set at a point east 20' from W.C. protrudes 3" above ground.

DOUGLAS COUNTY SURVEYORS
BO 1
PROJ. 4" WEST 20 FT
TO WC MC
1997
OFFICE

New BT- ~~6"~~ 11" dia. Ash double blazed and scribed "WC MC S9 CS BT", bears S.64½°E., 15.3'. NOW FULLY HEALED DOUBLE BLZ.

Fd. BC "BO1" - Not FD WC BC 3/2020 - N Hibbs - M176-72

NEW BT
16" MAPLE "WC MC S9" "CSBT" N81½°E, 26.0' FROM 5/8"x60" WC TO MC

CS 67/51-16