GOVERNMENT CORNER RESTORATION FORM

FILED
Date: 4/12/2022 By: SC
This survey consists of:
Map:
Narrative:
Corner Rpt: CS 67/52-11
DOUGLAS COUNTY SURVEYOR

TOWNSHIP 26S RANGE 2W SEC. 30 PLSS # 140200

DOUGLAS COUNTY OREGON DATE 1-26-22

Corner Designation

1/4 COR 30/31

Monument(s) Found: (Condition and Source)

DCSD Brass Cap proj 13"

Previous Renewals

DCSD 1967 CS 54/40-9
BLM Resurvey 2011 Vol 58 pg 22934

__ Condition report
__ Not Found
✓ Renewed
__ Unrecorded
__ Surveyed In

MONUMENT DETAIL

County Surveyors office
T26S R2W
1/4 S30/S31
1967

Accessories Found

12"x1 FT Root stob burned N 27°W 4.6 FT
25" Burnt Forked Hemlock N 28¼°E 15.9FT To PK nail RT side Center (REC 16.5)
24" Fir S40°W 8.5 FT P.K nail RT Side Center Healed blaze
Burnt 13" R. Cedar S83°W 10.2FT To PK Nail RT. Side Center (Rec 9.8 FT) Healed Blaze

C.S. File 67/52-11
1/4

RENEWAL

Monument Set (Procedure and Description)

MONUMENT DETAIL

New Accessories

26" D.Fir N 55°W 26.5 FT Small blaze and Scar Facing Corner PK Nail Rt. Side Center

Sketch of Monument, Accessories, and General Area

Lat. 43°16'17.56" N

Long 122°58'50.27" W

See Attached Sheet For Sketch

Location see BLM Renewal 2011

Location & Comments

Comp. Decline. 14 1/2° E

Agency DCSO

Party Chief S. Flouse

Note keeper

Witnesses J. Lorsung

REGISTERED PROFESSIONAL LAND SURVEYOR

OREGON JULY 14, 1978 RONALD A. QUIMBY 1654

Expires: 12/31/2022

CS 67/52-11

T26S, R02W, 140200 1/26/22

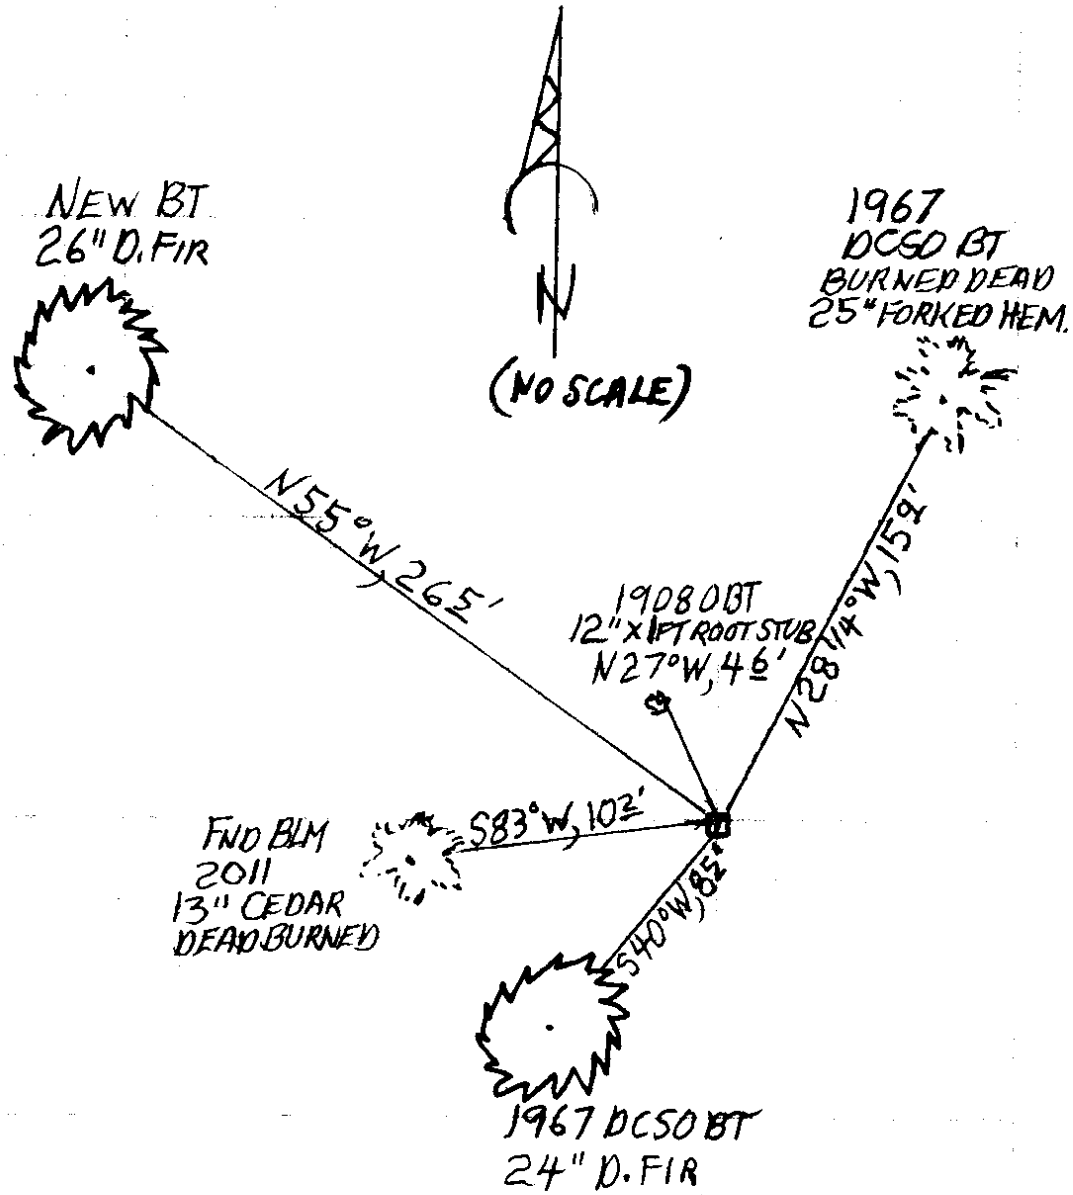

DECLINATION 14 1/2° E

CS 67/52-11

3/4

1/26/22

TOWNSHIP 26 RANGE 02 POINT IDENTIFIER # 140200

PRIMARY CORNER DESCRIPTION 1/4 Cor. Secs. 30 & 31

Alias _____ Description _____
Alias _____ Description _____
Alias _____ Description _____
Alias _____ Description _____

GLO survey by Wm. N Gibb, Deputy Surveyor, under contract No. 783, dated Dec. 3, 1908 - (DCSO records Vol. 10 Page(s) 4244)

Set cedar stake, 3 ft long, 4" sq, 24" in the ground for ¼ sec. cor. mkd ¼ S 30 on N & 31 on S face, from which
A laurel, 8" dia., bears S.21°W., 37 lks., mkd: ¼ S31 BT.
A laurel, 6" dia., bears N.27°W., 7 lks., mkd: ¼ S30 BT.

Douglas Co. Surveyors Office - Vernon "Ray" Tracy - Jack Heritage - E. West - March 1967 - C.S. File 54/40-9

Found - Orig. 6" now 8" laurel, alive, N.27°W., 4.6 ft prev. opened & shows "T" & frag. scribe on badly rotted blaze.
No trace of SW BT, call on creek to E fits good.

Set - Brass cap at cor. mkd: COUNTY SURVEYORS T26S R2W ¼ S 30 / S 31 1967 ✓ PROT. 13"

New BTs- 12" D.Fir S.40°W., 8.3 ft. mkd: ¼ S31 CS BT.
16" Hemlock (schoolmarm) N.31°E., 16.2 ft. mkd: ¼ S30 CS BT.

Note - This corner lies on moderate NE slope of small rounded spur sloping NW.

BLM Dependent Resurvey by Kenneth W. Saveland, Cadastral Surveyor, under Group No. 2331, Surveyed April/Oct. 2011 - (DCSO records Vol. 58 Page(s) 22934)

The ¼ sec. cor. of secs. 30 & 31, perpetuated by the Douglas County Surveyor's Office in 1967, monumented with an iron post, 1¼" dia, firmly set, projecting 10" above ground, with brass cap (properly) mkd.
from which an original bearing tree
12"x1FT ROOT STUB BURNED A madrone, 9" dia, bears N.27°W., 4.6 ft., with no marks visible on a previously chopped open and partially healed decayed blaze.
and BTs mkd. by the Douglas County Surveyor's Office
BURNED DEAD A forked hemlock, ~~23"~~ 25" dia, bears N.28¼°E., ~~16.5~~ ft., with a healed blaze. 15.9 TO RSC NAIL
ALIVE 24" D. FIR A fir, 22" dia, bears S.40°W., 8.5 ft. with a healed blaze RSC NAIL and a bearing tree mkd. by person(s) unknown
DEAD BURNED 13" R.CED A cedar, 13" dia, bears S.83°W. ~~9.8~~ ft with a healed blaze. -10.2 FT FHSB TO RSC NAIL
Corner is located 395 ft. S. of a double-poled, 3-strand power line, wires bear N.60°E. and S.60°W., and 435 ft. S. of a creek, 3 ft. wide, course N.60°W.
AS DESCRIBED Corner is further located 120 ft. W. of the head of a spring, 2 ft. wide, flows North.

NEW REF. ALIVE 26" D. FIR SMALL BLZ SCAR FACING COR. N 55° W, 26.5 FT. RSC NAIL

MM GPS TIME - 11:20
H.I. - 2.000 M CS 67/52-11 4/4 DECLINATION 14½°E