

GOVERNMENT CORNER RESTORATION FORM

FILED

TOWNSHIP 265 RANGE 3W SEC. 15 PLSS # 440420

Date: 2/28/2023 By: XC  
This survey consists of:

DOUGLAS COUNTY OREGON

DATE 2-18-23

Map: \_\_\_\_\_  
Narrative: \_\_\_\_\_  
Corner Rpt: CS 67/55-40

Corner Designation

CS 1/16 E 15

DOUGLAS COUNTY  
SURVEYOR

Monument(s) Found: (Condition and Source)

3/4" BLM BRASS CAP  
UP 4"

\_\_\_ Condition report

\_\_\_ Not Found

Renewed


\_\_\_ Unrecorded

\_\_\_ Surveyed In

Previous Renewals

Set by BLM 1984 Vol 47  
Pgs 17896-97

MONUMENT DETAIL

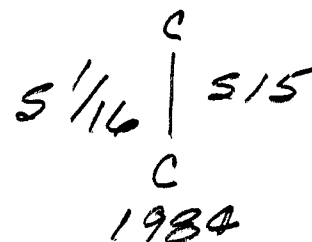

Accessories Found

BURNED Hollow 26" X 9" Broken OFF R. Cedar  
SWAG N65°E 4.0 FT BLAZE BURNED OUT  
ADD 3 1/2" MAG Nail RIGHT Side Center

BURNED still Alive 30" white fix N63°W  
22.1 FT Fully Healed Single BLAZE ADD 3 1/2"  
MAG Nail Left Side Center

C.S. File 67/55-40

RENEWAL

Monument Set (Procedure and Description)

MONUMENT DETAIL

---



---



---



---



---



---

New Accessories

---



---



---



---



---



---



---



---



---



---

Sketch of Monument, Accessories, and General Area

Location & Comments

OCRS COORDINATE SYSTEM  
 Cottage Grove - Canyonville  
 Zone

GRADE ROAD  
 North 120' E  
 AREA BURNT  
 9-2020

N 171816.796  
 E 242204.334

Comp. Decline. 14 1/2° E  
 Agency DCSO  
 Party Chief S. F. Fause  
 Note keeper  
 Witnesses J. Loring



EXPIRES: 12/31/2024

CS 67/55-40

# County Surveyor's Record, Douglas County, Oregon

**17896** Dependent Resurvey, Portion of Subdivisional Lines,  
T. 26 S., R. 3 W., Willamette Meridian, Oregon

**CHAINS**

and a bearing tree mkd. by White, Beck, and Reynolds

A cedar, 27 ins. diam., bears N. 47° E., 110 lks. dist., with healed blaze.

No suitable trees available within limits in sec. 10.

Land, mountainous.

Soil, rocky clay.

Timber, fir, cedar, pine, hemlock, oak, yew, and dogwood; undergrowth, vinemaple, poison oak, salal, hazel, and fern.

Subdivision of Section 15, T. 26 S., R. 3 W.,  
Willamette Meridian, Oregon

From the  $\frac{1}{4}$  sec. cor. of secs. 15 and 22, monumented with an iron post, 2 $\frac{1}{2}$  ins. diam., firmly set, projecting 4 ins. above ground, with brass cap mkd.

T 26 S R 3 W  
 $\frac{1}{4}$   $\frac{S 15}{S 22}$   
1962

from which the remains of bearing trees mkd. by White, Beck, and Reynolds

A cedar stump, 21 ins. diam., bears S. 51° E., 80 lks. dist., with fragmentary scribe marks visible on partially healed blaze.

A fir snag, 54 ins. diam., bears N. 5° W., 125 lks. dist., with fragmentary scribe marks visible on partially healed blaze.

and new bearing trees

A fir, 8 ins. diam., bears S. 4° E., 5 lks. dist., mkd.  $\frac{1}{4}$  S22 BT.

A fir, 5 ins. diam., bears N. 18° W., 17 lks. dist., mkd. X BT

N. 1° 31' W., on the N. and S. center line of sec. 15, marking and blazing the true line.

Descend over N. slope, through heavy timber and dense undergrowth.

11.90 Dirt road, 15 lks. wide, bears N. 75° E. and S. 75° W.

20.28 Point for the center S  $\frac{1}{16}$  sec. cor. of sec 15.

Set an iron post, 28 ins. long, 2 $\frac{1}{2}$  ins. diam., 24 ins. in the ground, with brass cap mkd.

T26S, R03W 440420

3 $\frac{1}{4}$ " BC.  
PROT 4"

C ✓  
S 1/16 | S 15  
C  
1984

RENEWED 2/13/23

CS 67/55-46  
3/4

County Surveyor's Record, Douglas County, Oregon  
 RTK ORCS CANYONVILLE COORD.S  
 171816.796 N, 242204.334 E

17897

Subdivision of Section 15, T. 26 S., R. 3W.,  
 Willamette Meridian, Oregon

CHAINS	R. from which	ADD 3 1/2" MAG NAIL R.S.C. " " " L.S.C.
BURNED HOLLOW BROKEN OFF 26" X 9 FT SNAG	✓ 40 FT. A cedar, 20 ins. diam., bears N. 65° E., 6 lks. dist., mkd. CS 1/16 S15 BT. BLAZE BURNED OUT	
BURNED STILL ALIVE 30"	✓ A white fir, 20 ins. diam., bears N. 63° W., 23 1/2 lks. dist., mkd. CS 1/16 S15 BT. FHSB Descend over NW. slope.	
21.95	Gravelled road, 20 lks. wide, bears N. 70° E. and S. 70° W.	
40.56	Point for the center 1/4 sec. cor. of sec. 15, at intersection with the E. and W. center line.  Set an iron post, 28 ins. long, 2 1/2 ins. diam., 24 ins. in the ground, with brass cap mkd.	
	T 26 S R 3 W C 1/4 S 15 1984	
	from which	
	A fir, 3 ins. diam., bears N. 50 1/4° E., 10 lks. dist., mkd. X BT	
	A yew, 15 ins. diam., bears S. 283/4° W., 46 lks. dist., mkd. C 1/4 S 15 BT.	
	Descend over NW. slope.	
60.92	Point for the center N 1/16 sec. cor. of sec. 15.  Set an iron post, 30 ins. long, 2 1/2 ins. diam., with plastic magnetic breakaway base. 26 ins. in the ground, with brass cap mkd.	
	C N 1/16   S 15 C 1984	
	from which	
	A cedar, 27 ins. diam., bears N. 41 1/2° E., 61 lks. dist., mkd. CN 1/16 S 15 BT	
	A white fir, 9 ins. diam., bears S. 30° W., 9 lks. dist., mkd. CN 1/16 S 15 BT.	
	Descend over NW. slope.	
63.65	Creek, 5 lks. wide, course N. 45° E.; asc over SE. slope.	
81.28	The 1/4 sec. cor. of secs. 10 and 15, monumented with an iron post, 2 1/2 ins. diam., firmly set, projecting 2 ins. above ground, with brass cap mkd.	
	T 26 S R 3 W 1/4 S 10 S 15 1962	

CS 67/55-40  
A/A