

GOVERNMENT CORNER RESTORATION FORM

FILED

TOWNSHIP 25S RANGE 2W SEC. 29

PLSS # 220220

Date: 3/21/2023 By: sc

This survey consists of:

Map: _____

Narrative: _____

Corner Rpt: 67/55-53

DOUGLAS COUNTY OREGON

DATE 5-3-22

DOUGLAS COUNTY
SURVEYOR

Corner Designation

SW 1/4 529

Monument(s) Found: (Condition and Source)

BLM BRASS CAP

up 2"

Condition report

Not Found

Renewed

Unrecorded

Surveyed In

Previous Renewals

BLM Established

1993 Vol 51 pg 19427-28

MONUMENT DETAIL

Accessories Found

A 10" D. FIR N 69 1/2° W 33.0 FT

A 10" D FIR N 15 3/4° W 21.8 FT

C.S. File 67/55-53

RENEWAL

Monument Set (Procedure and Description)

MONUMENT DETAIL

New Accessories


Sketch of Monument, Accessories, and General Area

Location & Comments

Lat 93°21'43.72" N
 Long 122°58'09.80" W

AREA BURN
 9-2020

Comp. Decline. 14 1/2° E
 Agency DCSO
 Party Chief S. FRAUSE
 Note keeper
 Witnesses J. LORSUNG

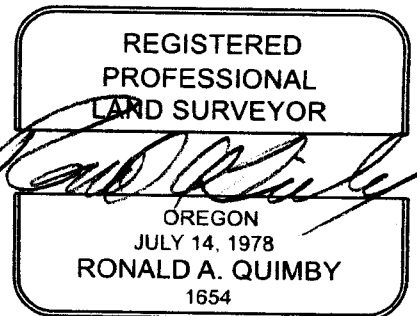

EXPIRES: 12/31/2024

CS 67/SS-53

214

MM GPS 5/3/22

43°21'43.72" N

TIME - 9:50

122°58'04.80" W

19427

H.I. - 2.000M

T25S, R2W,

220220

Subdivision of Section 29,
T. 25 S., R. 2 W., Willamette Meridian, Oregon
SOUTH OF ROCK CREEK TAKE SPUR OFF FIRST BRIDGE RD.

CHAINS	
	Deposit a white "DEEP-1" magnetic marker at the base of the stainless steel post.
	Descend over NE. slope.
26.00	Creek, 5 lks. wide, course N. 40° W.; asc. over SW. slope.
30.20	Spur, slopes N. 50° W.; desc. over NW. slope.
35.05	Ravine, drains S. 80° W.; continue over creek bottom.
41.170	The E 1/16 sec. cor. of secs. 20 and 29.
<hr/>	
	From the N 1/16 sec. cor. of secs. 28 and 29.
	N. 89° 24' 30" W., on the E. and W. centerline of the NE¼ of sec. 29.
	Ascend over broken NE. slope, through heavy timber and dense undergrowth.
4.00	Spur, slopes N. 30° W.; desc. over broken NW. slope changing to SW. slope.
14.40	Graveled road, 25 lks. wide, bears N. 20° W. and S. 20° E.
17.15	Creek, 3 lks. wide, course N. 20° W.; asc. over broken NE. slope.
20.320	The NE 1/16 sec. cor. of sec. 29.
	Ascend over NE. slope.
21.40	Spur, slopes N. 10° W.; desc. over broken NW. slope.
40.640	The center N 1/16 sec. cor. of sec. 29.
<hr/>	
	From the W 1/16 sec. cor. of secs. 29 and 32.
	N. 0° 57' 30" E., on the N. and S. centerline of the SW¼ of sec. 29.
	Descend over NE. slope through heavy timber and dense undergrowth.
6.50	Conley Creek, 15 lks. wide, course N. 60° W.; asc. over SW. slope.
12.50	Spur, slopes W.; desc. over NW. slope.
19.60	Conley Creek, 15 lks. wide, course N. 10° E.; desc. along NE. slope.
<u>20.220</u>	Point for the SW 1/16 sec. cor. of sec. 29 at intersection with the E. and W. centerline of the SW¼.
	Set a stainless steel post, 28 ins. long, 2½ ins. diam., 26 ins. in the ground, with brass cap mkd.
	SW 1/16 S29 1993

CS 67/55-53
3/4

Subdivision of Section 29,
T. 25 S., R. 2 W., Willamette Meridian, Oregon

CHAINS	
	<p>from which ¹⁰</p> <p>A fir, ⁸ ins. diam., bears N. 69½° W., 50 lks. dist., mkd. X BT. ³³²</p> <p>A fir, ¹⁰ ins. diam., bears N. 15 3/4° W., 33 lks. dist., mkd. SW 1/16 S29 BT. ²¹⁸</p> <p>Deposit a white "DEEP-1" magnetic marker at the base of the stainless steel post.</p> <p>Descend over NE. slope.</p>
21.75	Conley Creek, 15 lks. wide, course N. 60° W.; desc. over broken N. slope.
24.40	Graveled road, 15 lks. wide, bears NE. and SW.
34.45	Rock Creek, 60 lks. wide, course S. 65° W.; continue along creek bottom.
40.420	The center W 1/16 sec. cor. of sec. 29.
	<hr/> <p>From the center S 1/16 sec. cor. of sec. 29.</p> <p>N. 89° 22' 00" W., on the E. and W. centerline of the SW¼ of sec. 29.</p> <p>Descend over broken NW. slope, through scattering timber and moderate undergrowth.</p>
19.75	Conley Creek, 15 lks. wide, course N. 10° E.; asc. over broken NE. slope.
19.965	The SW 1/16 sec. cor. of sec. 29.
	Ascend over broken NE. slope.
24.95	Spur, slopes N. 10° W.; desc. over NW. slope.
30.30	Graveled road, 15 lks. wide, bears N. 60° E. and S. 60° W.
31.55	Bottom of descent, drains N.; asc. over NE. slope.
38.45	Top of ascent, slopes N.; desc. over NW. slope.
39.910	The S 1/16 sec. cor. of secs. 29 and 30.
	<hr/> <p>From the center W 1/16 sec. cor. of sec. 29.</p> <p>N. 0° 11' 00" E., on the N. and S. centerline of the NW¼ of sec. 29.</p> <p>Ascend over creek bottom, changing to a SW. slope, through scattering timber and moderate undergrowth.</p>
14.20	Spur, slopes N. 80° E.; desc. over NE. slope.

CS 67/55-53
4/4