

TOWNSHIP 255 RANGE 2W SEC. 20 PLSS # 260300

Date: 5-4-2023 By: X
This survey consists of:

DOUGLAS COUNTY OREGON

DATE 5-1-23

Map: _____

Narrative: _____

Corner Rpt: CS 67 | 56-10

Corner Designation

DOUGLAS COUNTY
SURVEYOR

E 1/16 S20
S29

Monument(s) Found: (Condition and Source)

Condition report

Not Found

Renewed

Unrecorded

Surveyed In

3 1/4" BLM BRASS CAP
UP 4"

Previous Renewals

Set by BLM 1993
Vol 51 pgs 19421-22

MONUMENT DETAIL

E 1/16 S20
S29
1993

Accessories Found

Buried dead 15" D. FIR N 36 3/4° E 29.0 FT
ADD 3 1/2" MAG NAIL RIGHT SIDE CENTER

Buried - dead 14" D. FIR S 26 1/2° E 21.8 FT
TO ROOT HOLE DOWN BURIED UNDER
BLOW DOWN MAPLES

RENEWAL

Monument Set (Procedure and Description)

MONUMENT DETAIL

New Accessories

BURNED - DEAD 15" D. FIR S32°W 23.3 FT
 3 1/2" MAG NAIL RIGHT SIDE CENTER NOT
 BLAZED OR SCRIBED


Sketch of Monument, Accessories, and General Area

Location & Comments

Lat: 42° 22' 23.33" N
 Long: 122° 57' 28.06" W

AREA BURNED
 9/2020

Comp. Decline. 14 1/2° E
 Agency DCSD
 Party Chief S. F. HAUSE
 Note keeper
 Witnesses J. KORSUNOV

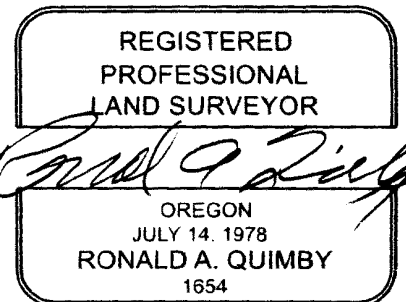

EXPIRES: 12/31/2024

CS 67/56-10

**Dependent Resurvey of a Portion of the Subdivisional Lines,
T. 25 S., R. 2 W., Willamette Meridian, Oregon**

CHAINS								
	<p>A chinquapin stump, 20 ins. diam., bears N. 65° E., 27 lks. dist., no marks visible.</p> <p>A chinquapin, 14 ins. diam., bears S. 69° E., 21 lks. dist., with decayed partially healed blaze.</p> <p>A cedar stump, 37 ins. diam., bears S. 24° W., 30 lks. dist., with healed blaze.</p> <p>and bearing trees mkd. by Byron</p> <p>A fir, 21 ins. diam., bears N. 3° E., 24 lks. dist., with healed blaze.</p> <p>A cedar, 16 ins. diam., bears S. 39° E., 32 lks. dist., with healed double blaze.</p> <p>A fir, 27 ins. diam., bears N. 4½° W., 43 lks. dist., with healed double blaze.</p> <p>and a new bearing tree</p> <p>A hemlock, 13 ins. diam., bears S. 78° W., 22 lks. dist., mkd. T25S R2W S30 BT.</p> <p>From this point, the Bureau of Land Management Geodetic Control Station No. EC 41167, at latitude 43° 22' 32.581" N., longitude 122° 58' 15.522" W. (NAD 1927), determined by the NAVSTAR Global Positional System, bears N. 28° 13' 54" E., 16.498 chs. dist. (mean bearing and sea level distance); monumented with an aluminum cap set flush with the ground, mkd. EC 41167 GPS 1992 and a triangle.</p>							
	<hr/> <p>From the cor. of secs. 20, 21, 28, and 29. <i>25, 2, 260300</i></p> <p>N. 89° 46' 00" W., bet. secs. 20 and 29.</p> <p>Descend over broken NW. slope through heavy timber and dense undergrowth.</p>							
3.60	Creek, 10 lks. wide, course S. 20° W.; desc. over broken W. slope.							
6.40	Creek, 10 lks. wide, course N. 40° W.; continue over creek bottom.							
7.10	Creek, 10 lks. wide, course S. 30° W.; continue over creek bottom.							
11.35	Creek, 10 lks. wide, course N. 50° W.; continue over creek bottom.							
20.285	Point for the E 1/16 sec. cor. of secs. 20 and 29.							
	<p>Set a stainless steel post, 28 ins. long, 2½ ins. diam., <i>5/1/23</i> 26 ins. in the ground, with brass cap mkd.</p> <p style="text-align: center;"><i>3 1/4" B.C.</i> E 1/16 <table style="display: inline-table; vertical-align: middle;"><tr><td>S 20</td><td>-----</td><td rowspan="3" style="font-size: 2em; vertical-align: middle;">✓</td></tr><tr><td>S 29</td><td>-----</td></tr><tr><td>1993</td><td></td></tr></table> <i>PROT 4"</i></p>	S 20	-----	✓	S 29	-----	1993	
S 20	-----	✓						
S 29	-----							
1993								
	from which							

*Vol 51 CS 67/56-10
3/4*

5/1/23

19422

Dependent Resurvey of a Portion of the Subdivisional Lines,
T. 25 S., R. 2 W., Willamette Meridian, Oregon

290 ADD 3 1/2" MAG-NAIL R.S.C.

CHAINS	
BURNED DEAD 15" D.	A fir, 7 ins. diam., bears N. 36 3/4° E., 44 lks. dist., mkd. E 1/16 S20 BT.
BURNED DEAD 14" D. FALLEN BURIED UNDER BLOW DOWN MAPLES	A fir, 7 ins. diam., bears S. 26 1/2° E., 33 lks. dist., mkd. E 1/16 S29 BT.
	Deposit a white "DEEP-1" magnetic marker at the base of the stainless steel post. NEW REF.
	Continue over creek bottom.
23.00	Rock Creek, 130 lks. wide, course S.; asc. over nearly level creek bottom.
35.90	Rock Creek Road, County Road No. 78A, paved, 30 lks. wide, bears N. 60° E. and S. 60° W.; begin ascent over broken SE. slope.
40.570	The 1/4 sec. cor. of secs. 20 and 29, monumented with an iron post, 2 1/2 ins. diam., firmly set, projecting 6 ins. above ground, with brass cap mkd.
	<p style="text-align: center;">S 20 1/4 ----- S 29 T25S R2W 1962</p>
	from which the remains of the original bearing trees
	A fir stump, 18 ins. diam., bears N. 27° E., 67 lks. dist., with scribe marks S BT visible on decayed blaze.
	A fir snag, 18 ins. diam., bears S. 50° E., 54 lks. dist., with healed blaze.
	and the remains of a bearing tree mkd. by Brooks
	A fir stump, 11 ins. diam., bears N. 49 1/2° W., 20 lks. dist., with decayed snag lying alongside, with healed blaze.
	and bearing trees mkd. by Randall Smith and Stephen J. Flause, Deputy County Surveyors, in 1986, as recorded in Douglas County Surveyor's Office C.S. File No. 62/31 and Corner Renewal T. 25 S., R. 2 W., No. 119
	A fir, 7 ins. diam., bears N. 18° E., 35 lks. dist., with healed blaze.
	A chinquapin, 8 ins. diam., bears N. 75° E., 43 lks. dist., with scribe marks 1/4 S20 CS BT visible on open blaze.
	A fir, 7 ins. diam., bears S. 25° W., 44 lks. dist., with healed double blaze.
	A fir, 11 ins. diam., bears S. 85° W., 33 lks. dist., with healed double blaze.
	S. 89° 28' 30" W., beginning new measurement.

BURNED DEAD 15" D. FIR 532° W, 233

3 1/2" MAG-NAIL R.S.C.

CS 67/56-10

414