

TOWNSHIP 255 RANGE 3W SEC. 34 PLSS # 460160

Date: 6/19/2023 By: JC
This survey consists of:

DOUGLAS COUNTY OREGON

DATE 5-30-23

Map: _____

Narrative: _____
Corner Rpt: CS 67/56-25

Corner Designation

DOUGLAS COUNTY
SURVEYOR

NE 1/16 S 34

Monument(s) Found: (Condition and Source)

___ Condition report

3 1/4" BLM BRASS CAP
UP 3"

___ Not Found

Renewed

___ Unrecorded

___ Surveyed In

Previous Renewals

BARNES 1963 CS 51/261
Weyerhaeuser Co. 1963 CS 53/113-15

MONUMENT DETAIL

NE 1/16 S 34
2008

Accessories Found

1" ID Iron Pipe N 70° 30' 33" E 16.11 FT 3"
below Ground (CORNER set by BARNES
CS 51/261)

BURNED Low Cut 17" X 4" Tall Fir Stump
N 38 1/4 E 20.2 FT FACE INSIDE TREE

BURNED DEAD 16" Fir S 19° E 28.5 FT (REC
S 24 1/2° E 29.4 FT) Fully heated Single BLAZE
ADD 3 1/2" MAG NAIL RIGHT SIDE CENTER

Rotted BURNED 35" X 3 FT FIR STUMP
N 27 3/4 W 31.8 FT NAIL IN FACE

New Accessories

BURNED - SAWN 16" X 1 FT D. FIRE STUMP
N26°W 3.3 FT 3 1/2" MAG. NAIL TOP
CENTER

Sketch of Monument, Accessories, and General Area

Location & Comments

OCRS COORDINATE SYSTEM
COTTAGE GROVE - CANYONVILLE
ZONE

AREA BURNED
9-2020

N 190559.742

E 243388.602

Comp. Decline. 14 1/2° E
Agency DCSO
Party Chief S. F. HAUSE
Note keeper
Witnesses J. LORSUNG

REGISTERED
PROFESSIONAL
LAND SURVEYOR

Ronald A. Quimby

OREGON
JULY 14 1978
RONALD A. QUIMBY
1654

EXPIRES: 12/31/2024

CS 67/56-25
2/6

Subdivision of Section 34,
T. 25 S., R. 3 W., Willamette Meridian, Oregon *REVIEWED 5/30/23*

FEET	
	<p><i>3 1/4" BC,</i> NE 1/16 S 34 2008 <i>PROT. 3"</i></p> <p>from which</p> <p><i>BURNED LOW CUT 17" x 4" STUMP</i> A fir, 43 ins. diam., bears N. 38 1/4° E., 20.2 ft. dist., mkd. X BT. <i>NO NAIL ADDED</i></p> <p><i>BURNED DEAD 16"</i> — A fir, 19 ins. diam., bears S. 26 1/2° E., 29.4 ft. dist., mkd. NE 1/46 <i>FACE INSIDE TREE</i> S34-BT. <i>FHSB ADD 3 1/2" MAG NAIL RSC</i></p> <p>Deposit a magnet in a white plastic case at the base of the stainless steel post. <i>NEW REF</i></p> <p><i>BURNED SAWN 16" x 1 FT D. FIR STUMP N 26° W, 33'</i> From this cor., a point established by William S. Barnes, Registered Professional Engineer No. 2128, in 1963, filed in the Douglas County Surveyors Office, C.S. File No. 51/261A, monumented by William L. Wilt, Land Agent, in 1963, filed in the Douglas County Surveyors Office, C.S. File No. 53/111, bears N. 70° 30' 33" E. <i>16.11'</i> dist., monumented with an iron pipe, 1 1/4 ins. diam., firmly set, projecting 1 in. above ground, from which the remains of reference trees mkd. by Barnes <i>1" I.D. I.P. 3" BELOW GRND.</i></p> <p><i>BURNED MOSTLY TO GRND.</i> A sawed, hollow cedar stump, 31 ins. diam., bears N. 88 1/4° W., 28.2 ft. dist., with a brass washer mkd. REG. ENGR. NO. ORE. 2128 and a metal tag.</p> <p><i>IN EVIDENCE B & D ROUGHLY CHECKED</i> <i>NOW ROTTED AND BURNED 35" x 3 FT</i> A sawed fir stump, 37 ins. diam., bears N. 27 3/4° W., 31.8 ft. dist., with axe marks and a brass washer mkd. REG. ENGR. NO. ORE. 2128 and a metal tag. <i>METAL TAG GONE, W NAIL IN FACE</i></p> <p><i>DECLINATION 14 1/2° E</i> This point was not correctly positioned and is not utilized in the course of this survey.</p> <p>Corner is located at the base of an E. slope, and N., 10 ft. dist. from a creek, 3 ft. wide, course S. 75° E.</p> <hr/> <p>From the N 1/16 sec. cor. of secs. 34 and 35.</p> <p>S. 84° 41' 41" W., on the E. and W. centerline of the NE 1/4 of sec. 34.</p> <p>125 Rock face, edge bears generally N. and S.</p> <p>1360.13 The NE 1/16 sec. cor. of sec. 34.</p> <hr/> <p><i>OGRS CANYONVILLE COTTAGE GROVE COORDS</i> <i>190559.762 N</i> <i>243388.602 E</i></p>

CS 67/66-25
3/6

weyerhaeuser Co
1963
CS 53/113-15

$\frac{34}{3}$

‡ Corner common to Sections 34-25S-3W and
3-26S-3W

GLO Survey Record, Dependent Resurvey approved 1/7/46

Brass Cap

Found

$\frac{34|35}{3|2}$

Section Corner common to Sections 34 and 35-25S-3W and
2 and 3-26S-3W

GLO Survey Record, Dependent Resurvey approved 1/7/46

Brass Cap

Found

NE 1/16

Corner for Section 34-25S-3W = Point "F"

Set 1" iron pipe for corner by double proportionate method

Referenced by W. Wilt (Weyerhaeuser Method with disc. #2128)
Declination 20°

26" R Cedar	S 89° W	25.8'
34" Fir	N 30° W	30.5'

CE 1/16


Corner for Section 34-25S-3W = Point "H"

Set 1" iron pipe for corner by single proportionate method


Referenced by W. Wilt (Weyerhaeuser Method with disc. #2128)

28" R Cedar	S 55° W	19.5'
10" R Cedar	N 35° W	26.0'

PUBLIC LAND CORNERS

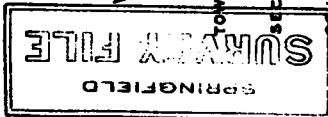

WEYERHAEUSER COMPANY
SPRINGFIELD BRANCH

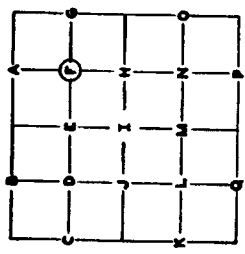

TOWNSHIP - 25 S RANGE - 3 W
SECTION - 34 CORNER "T" (US 1/16)
COUNTY - Douglas OREGON

GLO SURVEY RECORD

PRESENT CONDITION - (DESCRIBE FULLY - USE PAGE 2 IF NEEDED FOR EXPLANATION)

CORNER DATE: (See GLO Record)

ACCESSORIES:

BEARING- LINKS- FEET-

SURVEY RECORD DATE:

PRESENT CONDITION:

CORNER SET: 1" x 3/16" Iron Pipe set MAG. DECL: 20°

(Set at point established by: William S. Barnes Survey 6/63)

BEARING AND DISTANCE TO ABOVE IDENTIFIED SURVEY ACCESSORIES:

BEARING- FEET- SURVEY-

ACCESSORIES ADDED THIS DATE:

MAGNETIC DECLINATION 20°

BEARING	FEET	ORIG. B.T. "W" NAIL	PLATE	BRASS DISC
S89° W	25.8	X	X	No. 2128
N30° W	30.5	X	X	"

IDENTIFIED ON PHOTO:

INFORMATION ON LOCATION OF CORNER AS NOW SET:

GROUND COVER: Mixed stand unlogged, 2nd Gr. Fir, Cedar & Hemlock

(USING FORM LINES SKETCH TOPOG AT CORNER ON PAGE 2 PLAT)

SLOPE FACES (GIVE BEARING IN DEGREES) East ON MINUS (-) 11 %

NORTH: 1/16; mixed stand 2nd Gr. Fir, Cedar & Hemlock.

SOUTH: 10°; about 15' to spring branch, flowing N 60° E; same mixed stand; all timber in S.W. 1/4 to be logged 1958.

EAST: 11; 30° to same spring branch flowing N 60° E

WEST: 1/10; flattening into swampy area; uncut O.G. & 2nd growth Fir, Hemlock and Cedar.

WORK DONE FOR W. CO.

FIELD NOTES IN BOOK:

BY: William S. Barnes DATE: 6/27/63

ENGINEER - SUPERVISOR
LAND AGENT

ASSISTED BY:

UNDER THE SUPERVISION OF:

COPIES SENT TO:

SEAL

CS 67/56-25
466

CS 53/113-15

15