

GOVERNMENT CORNER RESTORATION FORM

TOWNSHIP 265 RANGE 1W SEC. 7 PLSS # 140540

FILED
Date: 12/7/2023 By: X
This survey consists of:

DOUGLAS COUNTY OREGON

DATE 11-22-23

Map: _____

Narrative: _____
Corner Rpt: CS 67/57-23

Corner Designation

C'1457

DOUGLAS COUNTY
SURVEYOR

Monument(s) Found: (Condition and Source)

BRASS CAP

Condition report

Not Found

Renewed

Unrecorded

Surveyed In

Previous Renewals

Established by GARRETT
1972 M 47-7

MONUMENT DETAIL

Accessories Found

SAWN BURNED 18" X 3 FT FIR STUMP S 28° W
12.5 FT HEALED BLAZE

SAWN BURNED 33" X 3 FT FIR STUMP N 36° E
23.2 FT HEALED BLAZE

C.S. File 67/57-23

RENEWAL

Monument Set (Procedure and Description)

MONUMENT DETAIL


New Accessories

Sketch of Monument, Accessories, and General Area

Location & Comments

OCRS COORDINATE SYSTEM
 Cottage Grove - Canyonville
 Zone
 N 178082.130
 E 288917.527

MON IS APPROX 60'
 WEST OF GRAVEL
 ROAD ON TOP OF
 STEEP ROCK FACE
 AREA BURNED
 9/2020
 Comp. Decline. 142° E
 Agency DCSO
 Party Chief S F/AUSE
 Note keeper
 Witnesses J LORSON

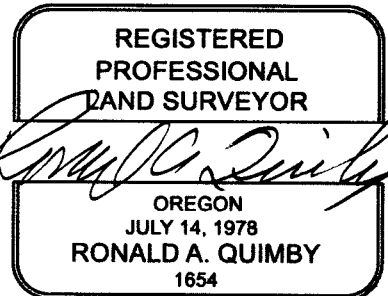

EXPIRES: 12/31/2024

CS 67/57-23
213

TOWNSHIP 26 RANGE 01 POINT IDENTIFIER # 140540

PRIMARY CORNER DESCRIPTION Center 1/4 Cor. Sec. 7

Alias _____	Description _____
Alias _____	Description _____
Alias _____	Description _____
Alias _____	Description _____

Don Garrett - For: United States of America - 10/1972 - M47-7

 Set - Brass cap, 60' above road surface, mkd: T26S R1W C4 S7
 1972 RPLS 544 ✓
 18" x 3^{FT} 13" Fir bears S.28°W. 12.5' ✓ scribed C4 S7 BT
 33" x 3^{FT} 25" Fir bears N.36°E. 23.2' ✓ scribed C4 S7 BT

RUNNED SAWED STUMPS, MONUMENT LIES 60' WEST
 OF GRAVEL ACCESS RD ON TOP OF A STEEP
 ROCK FACE.

OCRS N 178082.130
 E 288917.527

2,496' E FROM 700536
 SEARCH COR N 178082.130
 E 288917.527

CS 67/57-23
 3/3