Archie Creek Fire Corner Work Form
Pictures of Fire Damage Stored in GS16 Data Collector

Date 5/15/24				
Field Crew Time	Jeffery Lorsung, Stephen Flause : 3 HRS			
Review Time	Ron Quimby:			
Input Time	Jean Crawford:			
Equipment Used	Leica GS16 Base & Rover, Leica Total Station.			
Vehicle # 12-21-08	**Hours:** ✓ 3HRS	**Operator: Jeffery Lorsung**		
Fire	☑ Archie Creek			
Corner Information	**Township-Range-PLSS**	**Lat**	**Long**	**Monument Type**
	T25S-R01W-120640	NOT	FOUND	LOST DUE TO RD. ~~CONST.~~ CONSTRUCTION
Corner Damaged - Requires Restoration?	☑ Yes ☐ No			
Accessories Damaged – Requires Restoration?	Accessory 1: ☑ Yes ☐ No (BT)/IR Accessory 2: ☑ Yes ☐ No (BT)/IR Accessory 3: ☐ Yes ☐ No BT/IR Accessory 4: ☐ Yes ☐ No BT/IR Accessory 5: ☐ Yes ☐ No BT/IR Accessory 6: ☐ Yes ☐ No BT/IR Accessory 7: ☐ Yes ☐ No BT/IR Accessory 8: ☐ Yes ☐ No BT/IR Accessory 9: ☐ Yes ☐ No BT/IR			

Searched For Not Found

FILED
Date: 5/21/2024 By: SC
This survey consists of:
Map: _____
Narrative: _____
Corner Rpt: CS67/57-60
DOUGLAS COUNTY
SURVEYOR

C.S. FILE 67/57-60

LOCATED in Section 6, T. 25 S., R. 1 W., W.M.
in Douglas County, Oregon.

August 11, 2008

Map: M156-53
Narrative
Corner Rpt:

DOUGLAS COUNTY SURVEYOR

MAP FILE M156

SURVEYED FOR: SENECA JONES TIMBER CO.
P.O. BOX 2129
ROSEBURG, OREGON 97470

AND

ROSEBURG RESOURCES CO.
P.O. BOX 1088
ROSEBURG, OREGON 97470

SURVEYED BY: DAVID EDWARDS LAND SURVEYING
P.O. BOX 361
OAKLAND, OREGON 97462
PHONE: (541) 459-0512

REGISTERED PROFESSIONAL LAND SURVEYOR
David A. Edwards
OREGON JULY 30, 1999
DAVID A. EDWARDS
2339
RENEWS 12/31/09

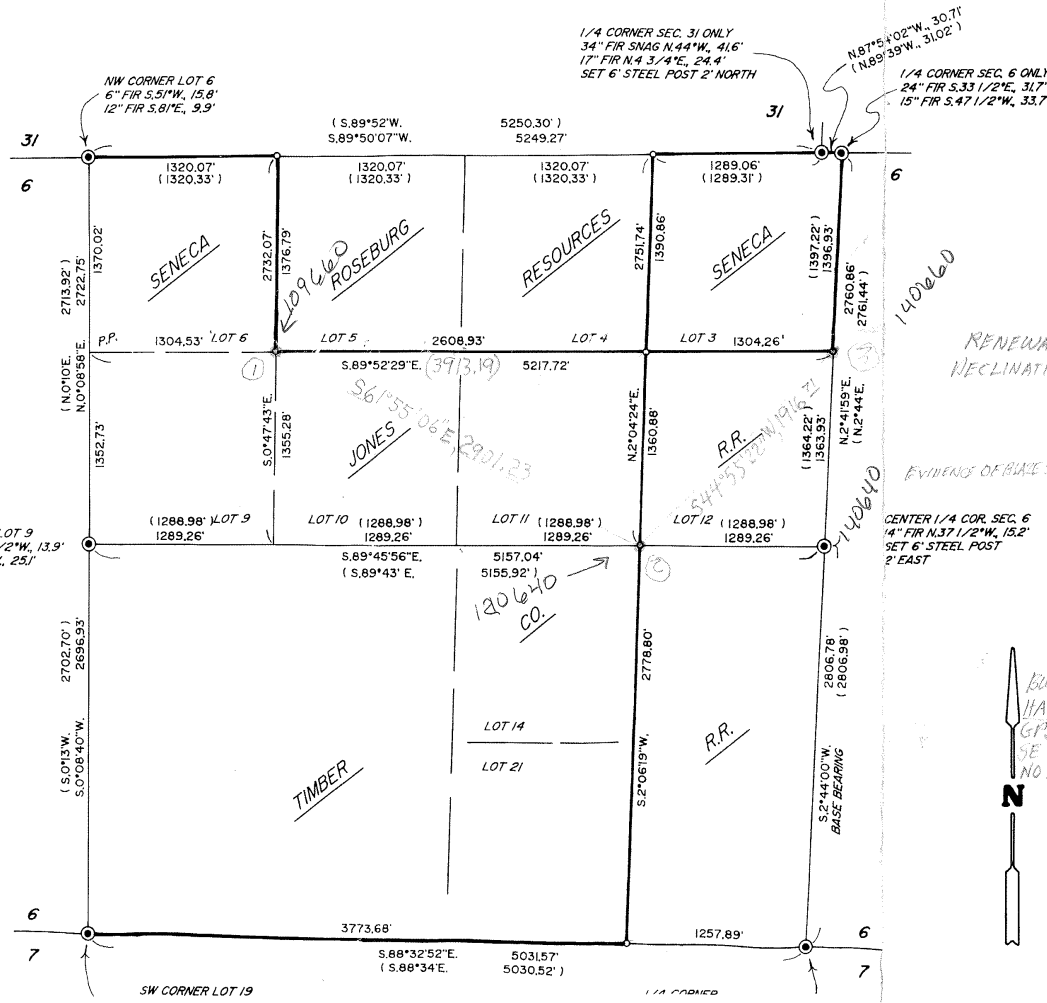

LEGEND

- ◉ INDICATES B.L.M. OR COUNTY SURVEYOR BRASS CAP FOUND.
- ○ INDICATES 5/8" X 30" STEEL REBAR WITH 2 1/2" DIAM. ALUM. CAP STAMPED WITH "LS 2339" AND "2008" AND GOV'T LOT DATA AS NOTED IN NARRATIVE.
- ( ) DENOTES B.L.M. RECORD DATA.
- ——— INDICATES BOUNDARY BLAZED AND POSTED THIS SURVEY.

P.P. = PROPORTIONATE POSITION.

SCALE: 1" = 600'

BASIS OF BEARINGS: B.L.M. RESURVEY AS SHOWN.

NARRATIVE

THE PURPOSE OF THIS SURVEY IS TO MARK THOSE BOUNDARIES SHOWN AS BOLD LINES AND TO MONUMENT CERTAIN GOV'T. LOT CORNERS AS SHOWN HEREON. THE BOUNDARIES WERE MARKED BY BLAZING TREES ON EACH SIDE OF THE LINE, BY SETTING 6 FOOT STEEL POSTS ALONG THE LINES AT INTERVALS OF 200' OR LESS AND BY HANGING LIBERAL AMOUNTS OF RED FLAGGING ALONG TRUE LINE. ALL FOUND BEARING TREES HAVE A HEALED BLAZE.

FOR CORNERS SET THIS SURVEY THE CAP MARKINGS AND BEARING TREES ARE AS FOLLOWS:

AT THE NE CORNER GOV'T. LOT 6 CAP IS STAMPED "NE COR. LOT 6 S6"
A 7" DIAM. FIR BEARS S.27°E., 21.3 FEET.
A 4" DIAM. FIR BEARS S.46°W., 10.8 FEET.
BOTH SCRIBED "NE L6 S6 BT"

AT THE NW CORNER GOV'T. LOT 3 CAP IS STAMPED "NW COR. LOT 6 S6"
A 10" DIAM. FIR BEARS S.54°W., 19.6 FEET.
A 10" FIR BEARS S.84°W., 13.4 FEET.
BOTH SCRIBED "NW L3 S6 BT"

AT THE SE CORNER GOV'T LOT 3 CAP IS STAMPED "SE COR. LOT 3 S6"
A 5" DIAM. CEDAR BEARS N.67°E., 5.9 FEET.
A 10" DIAM. FIR BEARS S.62°W., 8.2 FEET.
BOTH SCRIBED "SE L3 S6 BT"

AT THE SW CORNER GOV'T. LOT 3 CAP IS STAMPED "SW COR. LOT 3 S6"
A 14" DIAM. FIR BEARS N.66°E., 21.4 FEET.
A 5" DIAM. CHINQUAPIN BEARS S.27°W., 5.9 FEET.
BOTH SCRIBED "SW L3 S6 BT"

AT THE SE CORNER GOV'T. LOT 6 CAP IS STAMPED "SE COR. LOT 6 S6"
A 12" DIAM. FIR BEARS N.4°E., 7.9 FEET.
AN 8" DIAM. FIR BEARS N.70°W., 9.7 FEET.
BOTH SCRIBED "SE L6 S6 BT"

AT THE SE CORNER GOV'T. LOT 11 CAP IS STAMPED "SE COR. LOT 11 S6"
A 5" DIAM. FIR BEARS S.69°E., 14.9 FEET.
A 4" DIAM. FIR BEARS S.7°W., 18.8 FEET.
BOTH SCRIBED "SE L11 S6 BT"

AT THE SE CORNER GOV'T. LOT 21 CAP IS STAMPED "SE COR. LOT 21 S6"
A 6" DIAM. HEMLOCK BEARS N.28°E., 15.2 FEET.
A 31" DIAM. CEDAR BEARS S.79°E., 23.1 FEET.
BOTH SCRIBED "SE COR. LOT 21 S6 BT"

FIELD CREW: BRANT MILLER, ERIC SPRINKLE, CHRIS EDWARDS AND SULLIVAN EDWARDS.

EQUIPMENT: NIKON TOTAL STATION.

COMPUTATIONS AND DRAFTING: DAVID EDWARDS.

MAP FILE M1