

GOVERNMENT CORNER RESTORATION FORM

FILED

TOWNSHIP 255 RANGE 3W SEC. 30 PLSS # 110220

Date: 10/2/2024 By: JC
This survey consists of:

DOUGLAS COUNTY OREGON

DATE 9-19-24

Map: _____

Narrative: _____

Corner Rpt: CS 67/59-6

Corner Designation

CW SW 1/4

DOUGLAS COUNTY
SURVEYOR

Monument(s) Found: (Condition and Source)

2 1/2" Alum Cap on 5/8"
Iron Rod proj 4"

___ Condition report

___ Not Found

Renewed

___ Unrecorded

___ Surveyed In

Previous Renewals

Set by Hoffine 2007
M 154-16
Renewed 8/26/2021 Saily
CS 65/109-20

MONUMENT DETAIL

LONG ROCK TIMBER
CW SW 1/4
S 30
2007
PLS 2291

Accessories Found

BURNED SAWN 17" X 5 FT D. FIRE STUMP
S 56° E 56.2 FT (REC N 56° W) FULLY HEATED
SINGLE BLAZE ADD 3 1/2" MAG NAIL
Left Side Center

BURNED SAWN 13" X 5 FT D. FIRE STUMP
N 76° E 25.3 FT (REC S 76° W) FULLY HEATED
SINGLE BLAZE ADD 3 1/2" MAG NAIL
Left Side Center

Monument Set (Procedure and Description)

MONUMENT DETAIL

Blank lines for Monument Set description.

New Accessories

Blank lines for New Accessories description.

Sketch of Monument, Accessories, and General Area

Location & Comments

OERS Coordinate System
Cottage Grove - Canyonville
Zone
Cottage Grove - Canyonville
Zone


Small southerly
flowing stream is
1 FT. west of corner

AREA Burnt
9/2020

Comp. Decline. 14 1/4° E
Agency DCSO
Party Chief S. F. Hulse
Note keeper
Witnesses J. Corsun

N 193262.102
E 224250.962

CS 62/59-6
24

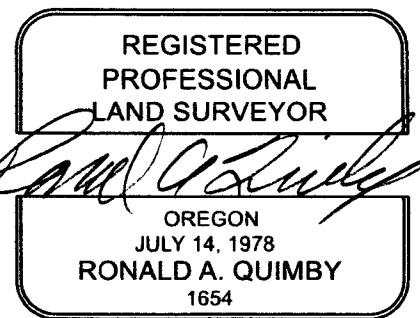

EXPIRES: 12/31/2024

RENEWED 9/19/24
DECLINATION 141/4°E

196305.539 N
226186.687 E

(10) OAKS DAMBOWVILLE CORNER 5/16" IRON ROD
BURNED SAUN D. FIR STAMP 19" X 4" FT
" " " 24" X 5 1/2" FT

RENEWED 7/19/24
DECLINATION 141/4°E

(12) OAKS DAMBOWVILLE COTTAGE SHED CORNER
195390.213 N
224860.513 E

BURNED SAUN 15" X 7" FT D. FIR STAMP
BURNED SAUN 26" X 5" FT D. FIR STAMP
SAUN 17" X 7" FT D. FIR STAMP

RENEWED 9/19/24
DECLINATION 141/4°E

(13) OAKS DAMBOWVILLE COTTAGE GARAGE CORNER
193262.102 N
224250.962 E

BURNED SAUN D. FIR STAMP 17" X 5" FT (BOTH BT
BURNED SAUN D. FIR STAMP 13" X 5" FT (BOTH BT
BURNED SAUN D. FIR STAMP 13" X 5" FT (BOTH BT

175 423 1.03 FEET ABOVE GROUND ON A FLAT RIDGE TOP THAT BEARS N 84° W. PLACED A IRON
WEST OF RIDGE LINE. PLACED A IRON FENCE POST 0.5 FEET NORTH OF THE CORNER
- 10" DOUGLAS FIR BEARS S 8 1/2° W 29.5 FEET WE SCRIBED CE 1/16 S30 BT AND TAGGED TREE
- 20" DOUGLAS FIR BEARS N 21° E 37.2 FEET WE SCRIBED CE 1/16 S30 BT AND TAGGED TREE
(9) THE NE 1/16 OF SECTION 30
SET 5/8" X 40" IRON ROD WITH A 2 1/2" ALUMINUM CAP MARKED LONE ROCK TIMBER NE 1/16 S30 2007
PLUS 2291 0.3 FEET ABOVE GROUND ON A STEEP NORTH FACING SLOPE APPROXIMATELY 60 FEET
NORTH OF A SMALL CLEAR CUT. PLACED A IRON FENCE POST 0.5 FEET TO THE NORTH OF THE
CORNER.

- 20" DOUGLAS FIR BEARS S 33° W 17.9 FEET WE SCRIBED NE 1/16 S30 BT AND TAGGED TREE
- 16" DOUGLAS FIR BEARS N 42 1/2° W 20.5 FEET WE SCRIBED NE 1/16 S30 BT AND TAGGED TREE
THE CN 1/16 OF SECTION 30 CAP AND IRON ROD AS DESCRIBED. WIRE FENCE CORNER 25 FT = 20 FT RUN
SET 5/8" X 40" IRON ROD WITH A 2 1/2" ALUMINUM CAP MARKED LONE ROCK TIMBER CN 1/16 S30 2007
PLUS 2291 0.3 FEET ABOVE GROUND ON A FLAT RIDGE TOP THAT BEARS N 84° W. PLACED A IRON
FENCE POST 0.5 FEET TO THE NORTH OF THE CORNER.

- 18" DOUGLAS FIR BEARS S 21 1/2° W 23.9 FEET WE SCRIBED CN 1/16 S30 BT AND TAGGED TREE FHSB
- 22" DOUGLAS FIR BEARS S 49° 42' 8" W 32.8 FEET WE SCRIBED CN 1/16 S30 BT AND TAGGED TREE FHSB
SET 5/8" X 40" IRON ROD WITH A 2 1/2" ALUMINUM CAP MARKED LONE ROCK TIMBER CSN 1/16 S30 2007
SET 2291 0.3 FEET ABOVE GROUND ON A GENTLE WEST FACING SLOPE. PLACED A IRON FENCE POST
0.5 FEET TO THE NORTH OF THE CORNER.

- 25" DOUGLAS FIR BEARS S 29° W 34.5 FEET WE SCRIBED CSN 1/16 S30 BT AND TAGGED TREE
- 20" DOUGLAS FIR BEARS N 49 1/2° E 35.3 FEET WE SCRIBED CSN 1/16 S30 BT AND TAGGED TREE
THE CSNW 1/64 OF SECTION 30 CAP AND IRON ROD AS DESCRIBED. WIRE FENCE BUILT TO SOUTH OF FENCES RUN
SET 5/8" X 40" IRON ROD WITH A 2 1/2" ALUMINUM CAP MARKED LONE ROCK TIMBER CSNW 1/64 S30 2007
PLUS 2291 0.2 FEET ABOVE GROUND ON A FLAT BENCH APPROXIMATELY 150 FEET EAST OF GRAVEL AND PA
ROAD. PLACED A IRON FENCE POST 0.5 FEET TO THE NORTH OF THE CORNER.

- 12" DOUGLAS FIR BEARS S 2° E 22.38 FEET WE SCRIBED CSNW 1/64 S30 BT AND TAGGED TREE FHSB
- 23" DOUGLAS FIR BEARS N 29 1/2° E 30.1 FEET WE SCRIBED CSNW 1/64 S30 BT AND TAGGED TREE FHSB
- 13" DOUGLAS FIR BEARS N 52° E 57.3 FEET WE SCRIBED CSNW 1/64 S30 BT AND TAGGED TREE FHSB
THE CW 1/16 OF SECTION 30 ADD 3 1/2" MAGNANIS AS TO BT'S
SET 5/8" X 40" IRON ROD WITH A 2 1/2" ALUMINUM CAP MARKED LONE ROCK TIMBER CW 1/16 S30 2007
PLUS 2291 0.4 FEET ABOVE GROUND ON A GENTLE SOUTH FACING SLOPE APPROXIMATELY 2 FEET EAST
OF OLD FENCE LINE. PLACED A IRON FENCE POST 0.5 TO THE NORTH OF THE CORNER.

- 12" CEDAR BEARS S 61° W 8.4 FEET WE SCRIBED CW 1/16 S30 BT AND TAGGED TREE
- 15" CEDAR BEARS N 71° E 57.5 FEET WE SCRIBED CW 1/16 S30 BT AND TAGGED TREE
(14) THE SW 1/16 OF SECTION 30
SET 5/8" X 40" IRON ROD WITH A 2 1/2" ALUMINUM CAP MARKED LONE ROCK TIMBER SW 1/16 S30 2007
PLUS 2291 0.4 FEET ABOVE GROUND ON FLAT BENCH APPROXIMATELY 15 FEET EAST OF OLD FENCE
LINE. PLACED A IRON FENCE POST 0.5 FEET TO THE NORTH OF THE CORNER.

- 11" DOUGLAS FIR BEARS N 10° W 32.7 FEET WE SCRIBED SW 1/16 S30 BT AND TAGGED TREE
- 16" DOUGLAS FIR BEARS S 41 1/2° W 20.4 FEET WE SCRIBED SW 1/16 S30 BT AND TAGGED TREE
THE CSW 1/64 OF SECTION 30 CAP AND IRON ROD AS DESCRIBED. WIRE FENCE BUILT TO SOUTH OF FENCES RUN
SET 5/8" X 40" IRON ROD WITH A 2 1/2" ALUMINUM CAP MARKED LONE ROCK TIMBER SW 1/16 S30 2007
PLUS 2291 0.3 FEET ABOVE GROUND. A SMALL SOUTHERLY FLOWING STREAM LIES 1 FOOT TO THE WEST
OF THE CORNER. PLACED A IRON FENCE POST 0.5 FEET TO THE NORTH OF THE CORNER. IRON ROD
- 17" DOUGLAS FIR BEARS N 56° W 58.2 FEET WE SCRIBED CSW 1/64 S30 BT AND TAGGED TREE FHSB
- 15" DOUGLAS FIR 78° W 25.3 FEET WE SCRIBED CSW 1/64 S30 BT AND TAGGED TREE FHSB
THE WW 1/64 OF SECTION 30 ADD 3 1/2" MAGNANIS AS TO BT'S
SET 5/8" X 40" IRON ROD WITH A 2 1/2" ALUMINUM CAP MARKED LONE ROCK TIMBER WW 1/64 S30 2007
PLUS 2291 0.2 FEET ABOVE GROUND ON A GENTLE SOUTH FACING SLOPE. THE CORNER LIES IN THREAD
THE NORTH OF THE CORNER.

- 14" DOUGLAS FIR BEARS S 87° E 24.3 FEET WE SCRIBED WW 1/64 S30 BT AND TAGGED TREE
- 18" DOUGLAS FIR N 75° E 12.9 FEET WE SCRIBED WW 1/64 S30 BT AND TAGGED TREE
(15) MONUMENT DESCRIPTION CONT'D
A STEEL LATHIS 2 N10°E, 1 FT. DISTANT
A 5" DIAM WOOD CORNER POST 13 2 N50°E, 0 6 FT. DISTANT
WIRE FENCES RUN EAST AND SOUTH

MAP FILE M154-16

CS 67/92-4
314

