

GOVERNMENT CORNER RESTORATION FORM

FILED

TOWNSHIP 25S RANGE 2W SEC. 29

PLSS # 200220

Date: 10/28/2024 By: [Signature]

This survey consists of:

Map: _____

DOUGLAS COUNTY OREGON

DATE 10-2-24

Narrative: _____

Corner Rpt: CS67/59-B

Corner Designation

S 1/16 S30/S29

DOUGLAS COUNTY
SURVEYOR

Monument(s) Found: (Condition and Source)

3 1/4" BLM BRASS CAP
PROJ 4" IN ROUGH STONE
MOUND CAP IS ORIENTED SOUTH

___ Condition report

___ Not Found

Renewed

___ Unrecorded

___ Surveyed In

Previous Renewals

Set by BLM 1993 Vol
51 pg 19419

MONUMENT DETAIL

S 1/16
S30/S29
1993

Accessories Found

Burnt- DEAD 14" Hemlock N44°E 21.7 FT
(Rec 33 LKS) BLAZE BURNED OUT ADD
3 1/2" MAG NAIL RIGHT SIDE CENTER

Burnt- DEAD 21" FIRE 532°E 76.1 FT
(Rec 115 LKS) FULLY HEALED SINGLE BLAZE
ADD 3 1/2" MAG NAIL RIGHT SIDE CENTER

GALVANIZED Post 1.0 FT West

C.S. File 67/59-B

Blank lines for Monument Set (Procedure and Description)

New Accessories

Blank lines for New Accessories

Sketch of Monument, Accessories, and General Area

Location & Comments

MON ON Relative FLAT Ground
S.E QUAD IS BURNT old Reprod
Rest is Cleared. Line of
Burnt timber Runs North
From corner

AREA BURNT
9-2020


OCRS Coordinate System
Cottage Grove - Canyonville
Zone

Comp. Decline. 14 1/4° E
Agency DCSO
Party Chief S. F. HAUSE
Note keeper
Witnesses J. LORSUNG

N 192975.182
E 259891.243



Ronald A. Quimby

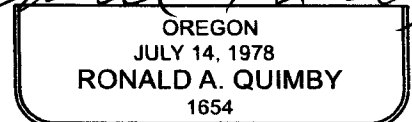

EXPIRES: 12/31/2024

CS 67/59-B

UO/SI 19419

Dependent Resurvey of a Portion of the Subdivisional Lines,
T. 25 S., R. 2 W., Willamette Meridian, Oregon

CHAINS	
	and a bearing tree mkd. by Brooks
	A fir, 26 ins. diam., bears N. 78° E., 21 lks. dist., with healed blaze.
	and the remains of bearing trees mkd. by Wofford, Berry, Popken, and Baughman
	A sawed hemlock stump, 19 ins. diam., bears S. 3° E., 55 lks. dist., with partially healed blaze.
	A fir, 18 ins. diam., bears S. 17° W., 94 lks. dist., with healed blaze.
	and a new bearing tree
	A hemlock, 4 ins. diam., bears S. 29½° E., 40 lks. dist., mkd. X BT.
	The corner is located on a spur, sloping N. 20° E.
	N. 1° 05' 00" E., bet. secs. 29 and 30.
	Descend along broken NW. slope along timber edge, with clearcut to the west.
16.60	Graveled road, 25 lks. wide, bears E. and N. 65° W.
20.300	Point for the S 1/16 sec. cor. of secs. 29 and 30.
	DECLINATION 14 1/4° E Set a stainless steel post, 28 ins. long, 2 1/2 ins. diam., 24 ins. in the ground, with brass cap mkd.
	CAP IS ORIENTED SOUTH PROT 4 INS. SURROUNDED BY ROUGH MOUND OF STONE S 1/16 S 30 * S 29 1993 A 3 1/4" BRASS CAP 21Z
	from which
	BURNED DEAD 14" A hemlock, 7 ins. diam., bears N. 44° E., 33 lks. dist., mkd. X BT. BLAZE BURNED OUT, NO SCRBG. 76L
	BURNED DEAD 21" A fir, 13 ins. diam., bears S. 32° E., 115 lks. dist., mkd. S 1/16 S29 BT. FHSB ADD A 3 1/2" MAG NAIL R.S.C. TO BT'S
	Deposit a white "DEEP-1" magnetic marker at the base of the stainless steel post. A GALVANIZED METAL LATH SET 10 FT, WEST
	The corner is located in the edge of timber, with clearcut to the west. MONUMENT IS ON RELATIVELY FLAT GROUND SE QUADRANT IS BURNED OLD REPROD REST IS CLEARCUT, A LINE OF BURNED TIMBER RUNS NORTH FROM CORNER.
31.55	Rock Creek, 100 lks. wide, course N. 65° W.; asc. over broken S. slope.
40.600	The 1/4 sec. cor. of secs. 29 and 30, monumented with an iron post, 2 1/2 ins. diam., firmly set flush with the ground, with brass cap mkd.

MINI GIS
43.36217
122.97299

OCR S CANYONVILLE COTTAGE GROVE COORDS

192975.182 N

259891.243 E

CS 67/59-B

313