

TOWNSHIP 255 RANGE 3W SEC. 35 PLSS # 546100

Date: 12/5/2024 By: X
This survey consists of:

DOUGLAS COUNTY OREGON

DATE 12-3-24

Map: _____

Narrative: _____

Corner Rpt: CS 67/59-21

DOUGLAS COUNTY
SURVEYOR

Corner Designation 1/4 S 35 T255
S 2 T265

Monument(s) Found: (Condition and Source)

___ Condition report

FD DCSO BRASS CAP
1/4 9"

___ Not Found

Renewed

___ Unrecorded

___ Surveyed In

Previous Renewals

- GLD 1940 Vol 27 p 11506-07
- Mcchesney 1965 CS 53/115-2
- DCSO 1966 CS 54/27-33
- * Christensen 1999 M 133-77
- DCSO 2007 CS 67/24-46
- BLM Resurvey 2008 Vol 57 pgs
22418-19
- * DCSO 1997 CS 64/78-5
Accessories Found

MONUMENT DETAIL

DOUGLAS COUNTY
SURVEYORS
T255
1/4 S 35 R
52 3
W
T265
1997
OFFICE

BURNED - DEAD 19" D. FIRE N45 1/2° E 22.2 FT
Healed Double BLAZE ADD 3 1/2" MAG NAIL LEFT
Side Center

BURNED - DEAD 21" D. FIRE S33° E 24.5 FT (RBL
24.0 FT) Healed Double BLAZE ADD 3 1/2"
MAG NAIL RIGHT Side Center

Root Hole FALLEN SNAG BURNED TO 8"
S85° W 19.4 FT.

Metal Post 1 FT West

RENEWAL

Monument Set (Procedure and Description)

MONUMENT DETAIL

New Accessories

BURNED - DEAD 24" D. FIRE N 57° E 6.6 FT
3 1/2" WING NAIL RIGHT SIDE CENTER

Sketch of Monument, Accessories, and General Area

Location & Comments

OCRS Coordinate System
Cottage Grove - Canyonville
Zone


AREA BURNED
9-2020

N 186 256.084
E 247 265.153

Comp. Decline. 14 1/2° E
Agency DCSO
Party Chief S. F. HAUSE
Note keeper
Witnesses J. LORSUNG

CS 67/59-21

2/3

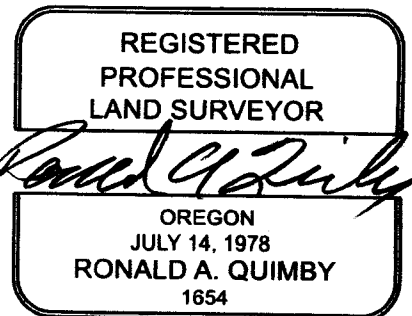

EXPIRES: 12/31/2024
24

TOWNSHIP 25 RANGE 03 POINT IDENTIFIER # 540100

PRIMARY CORNER DESCRIPTION 1/4 Cor. Sec. 35; & 2 of T 26-3

Alias _____	Description _____
Alias _____	Description <u>DCRS CANYONVILLE COTTAGE GROVE COORD.S</u>
Alias _____	Description _____
Alias _____	Description <u>186256.084 N</u>
	<u>247265.153 E</u>

BLM Dependent resurvey by A. Bert Skeesick & Kenneth W. Saveland, Cadastral Surveyors and Robert H. Browning, Survey Tech, under Group No. 2212 surveyed July/Oct. 2008 - (DCSO records Vol. 57 Page(s) 22418-9)

DECLINATION 14 1/2° E ----- *RENEWED 12/3/24*

The 1/4 sec. cor. of secs. 2 and 35, on the S. bdy. of the 1p., perpetuated by McChesney, in 1965, subsequently perpetuated by the Douglas County Surveyor's Office in 1966 and 1997, monumented with an iron post, 1 1/2" dia., firmly set, projecting 7" above ground, with brass cap (properly) mkd. from which the remains of bearing trees mkd. by Price A sawed fir stump, 47" dia., bears S. 51° W., 35.6 ft., with no marks visible. *BRUSH ON LINE NOT CHKD,*

and the remains of bearing trees mkd. by McChesney *GONE* - A roothole bears N. 18° E., 13.4 ft.

NO EVIDENCE A burnt, hollow cedar snag, size indeterminate, bears N. 49° W., 43.2 ft., with no marks visible.

and the remains of a bearing tree mkd. by the Douglas County Surveyor's Office in 1966

NO EVIDENCE A roothole bears S. 25° W., 67.9 ft., alongside of which is a down hemlock, 18" dia., with a healed blaze.

and the remains of bearing trees mkd. by Douglas County Surveyor's Office in 1997

BURNED DEAD 19" AD fir, 17" dia., bears N. 45° E, 22.2 ft., with a healed double blaze. *ADD 3 1/2" MAG NAIL LSC*

BURNED DEAD 21" AD fir, 16" dia., bears S. 33° E, 24.5 ft., with a healed double blaze. *ADD 3 1/2" MAG NAIL RSC*

FALLEN SNAG BURNED TO A roothole bears S. 85° W., 19.4 ft., alongside of which is a down fir snag, 9" dia., with a healed double blaze. *BLZ. NOT SEEN*

GONE NO EVIDENCE A roothole bears N. 54° W., 20.3 ft., alongside of which is a down fir snag, 7" dia., with scribe marks visible on upper portion and BT visible on lower portion of a partially healed double blaze.

Corner is located on a gradual, broken, SE. slope. The geographic position (NAD 1983 (CORS 96)) of the following corners, as determined by a tie from a temporary GPS control point, established utilizing dual frequency, carrier phase GPS receivers, using for control National Spatial Reference System Continuously Operating Reference Station (CORS) "DODSON BUTTE CORS ARP", and National Cooperative CORS Network Station "ROSEBURG COOP CORS ARP", are as follows:
Latitude: 43°20'38.07"N. Longitude: 123°01'13.77"W.

NEW REF.

24" BURNED DEAD D. FIR 3 1/2" MAG NAIL RSC TREE BEARS N 57° E, 66 FT.
FND METAL LATH 1 FT. WEST *CS 67/59-21 3*
3/3