SC01 1971-001

SEC. 27, TWP. 30S., RG. 5 W.W.M.

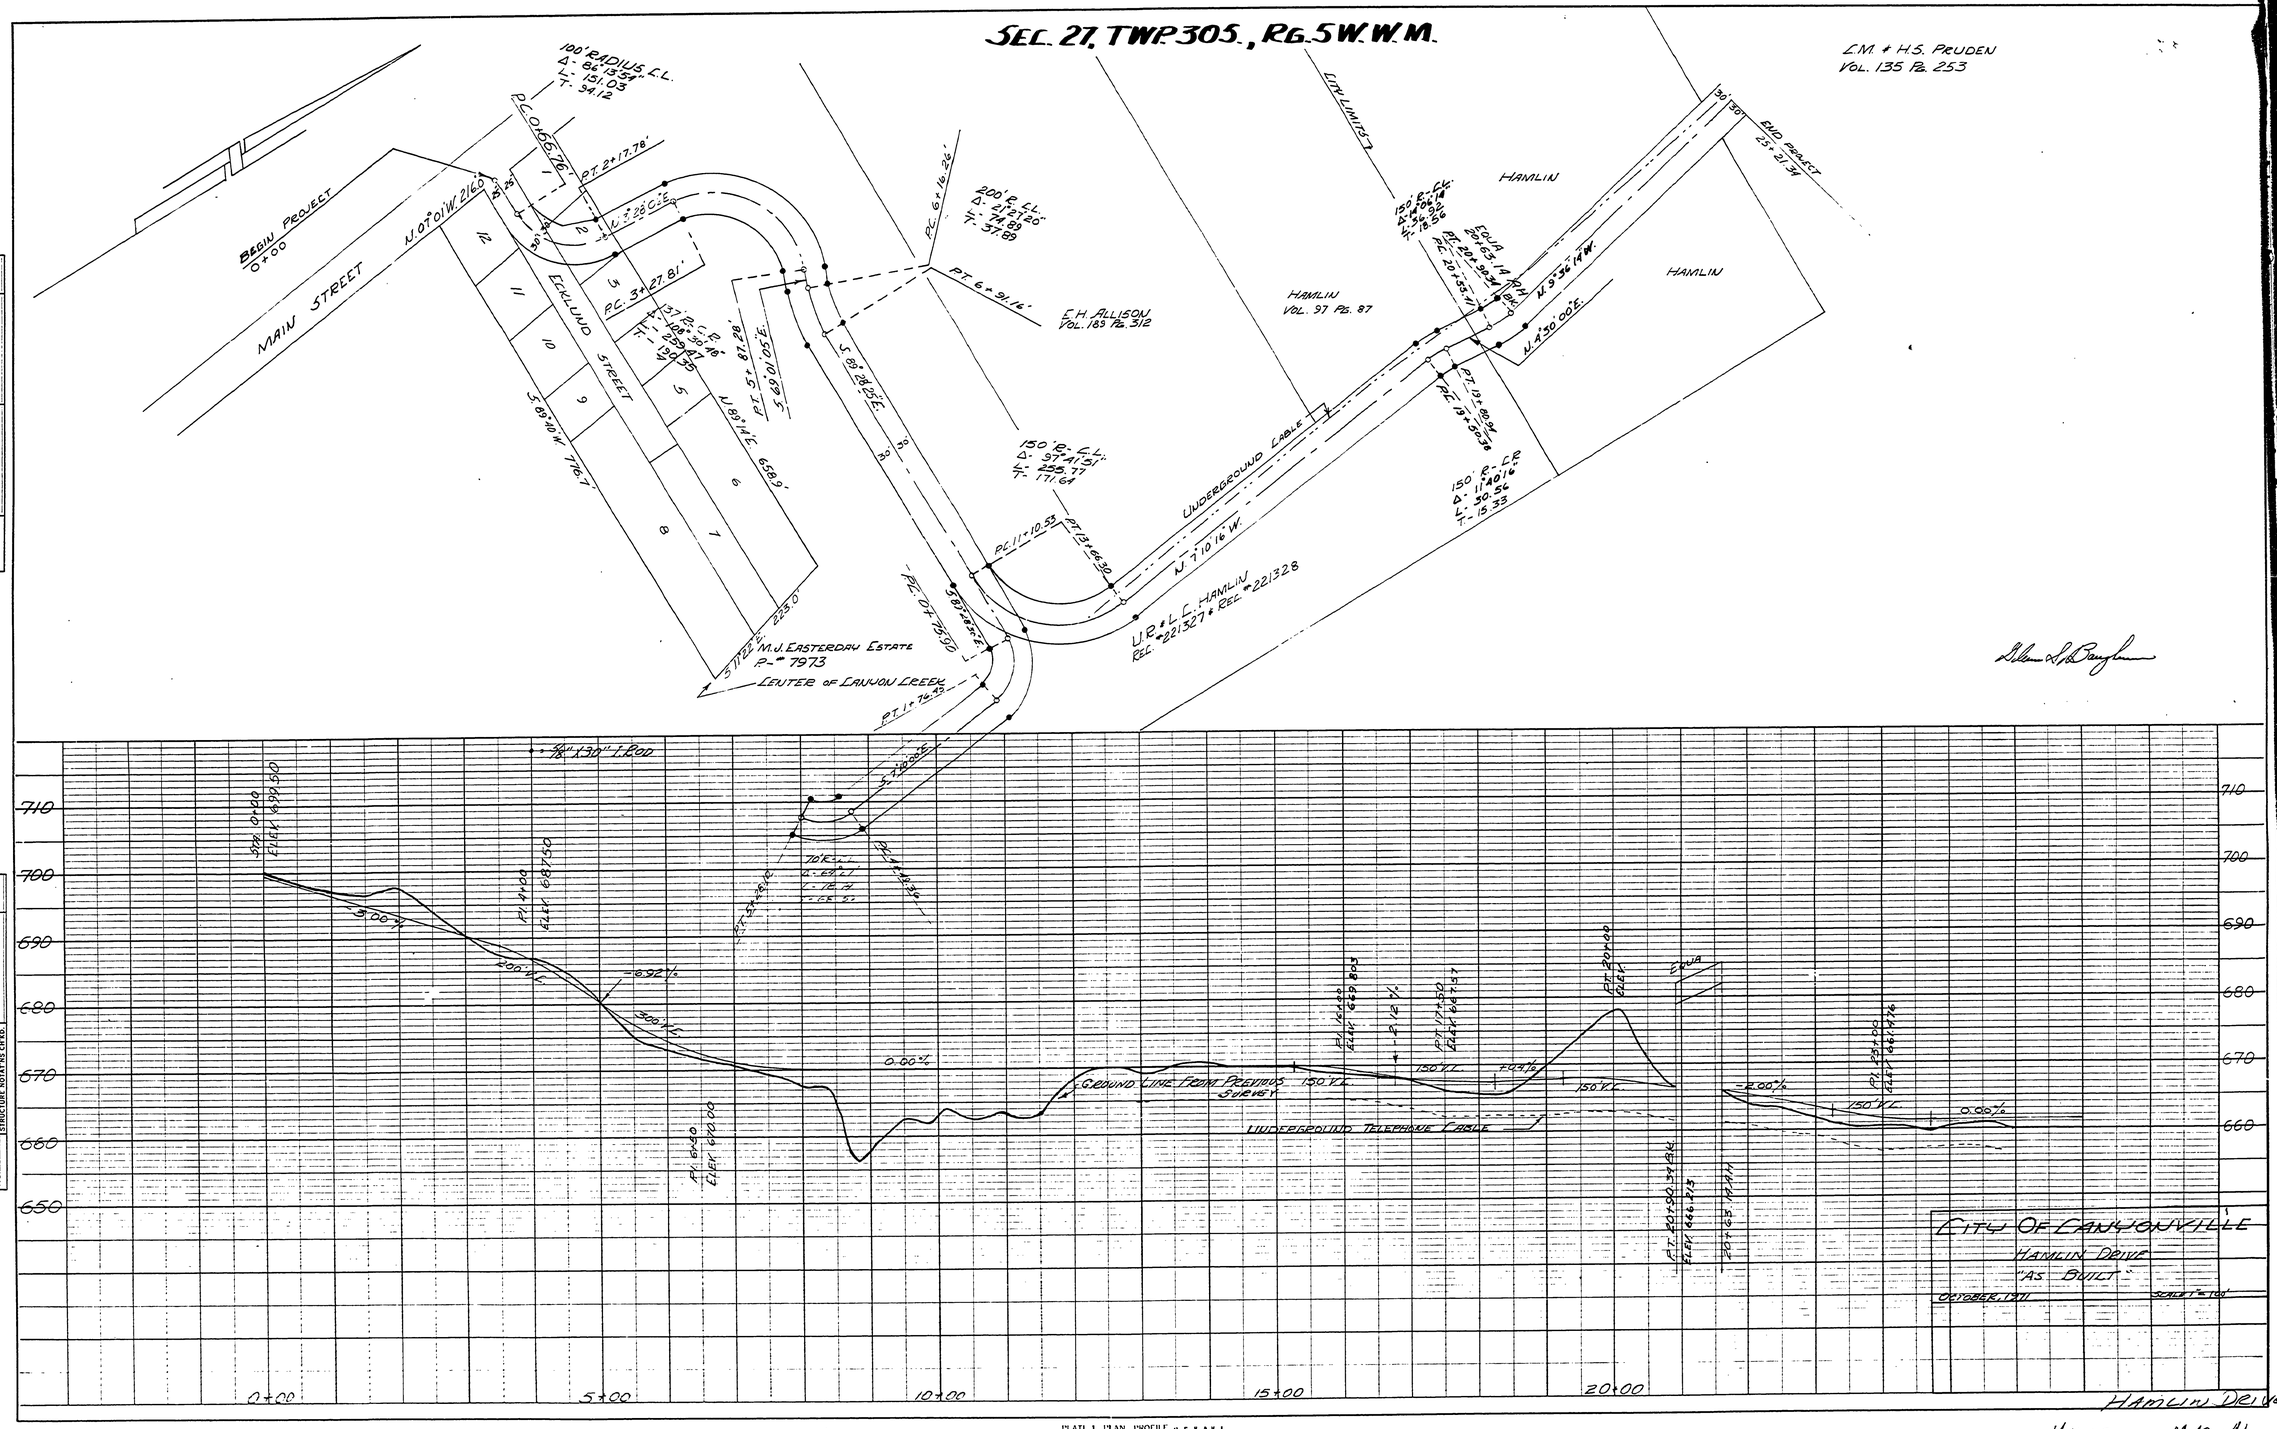

PLAN — SURVEYED ____ PLOTTED ____ ALIGNMENT CHECKED ____ RT. OF WAY CHECKED ____ NOTE BOOK ____ NO. ____ BY ____ DATE ____

PROFILE — SURVEYED ____ PLOTTED ____ GRADE CHECKED ____ B.M. & TIES ____ STRUCTURE NOTATNS CH'KD. ____ NOTE BOOK ____ NO. ____ BY ____ DATE ____

PLATE I PLAN PROFILE

MYLAR FILED IN M42-41

SC01 1971-001