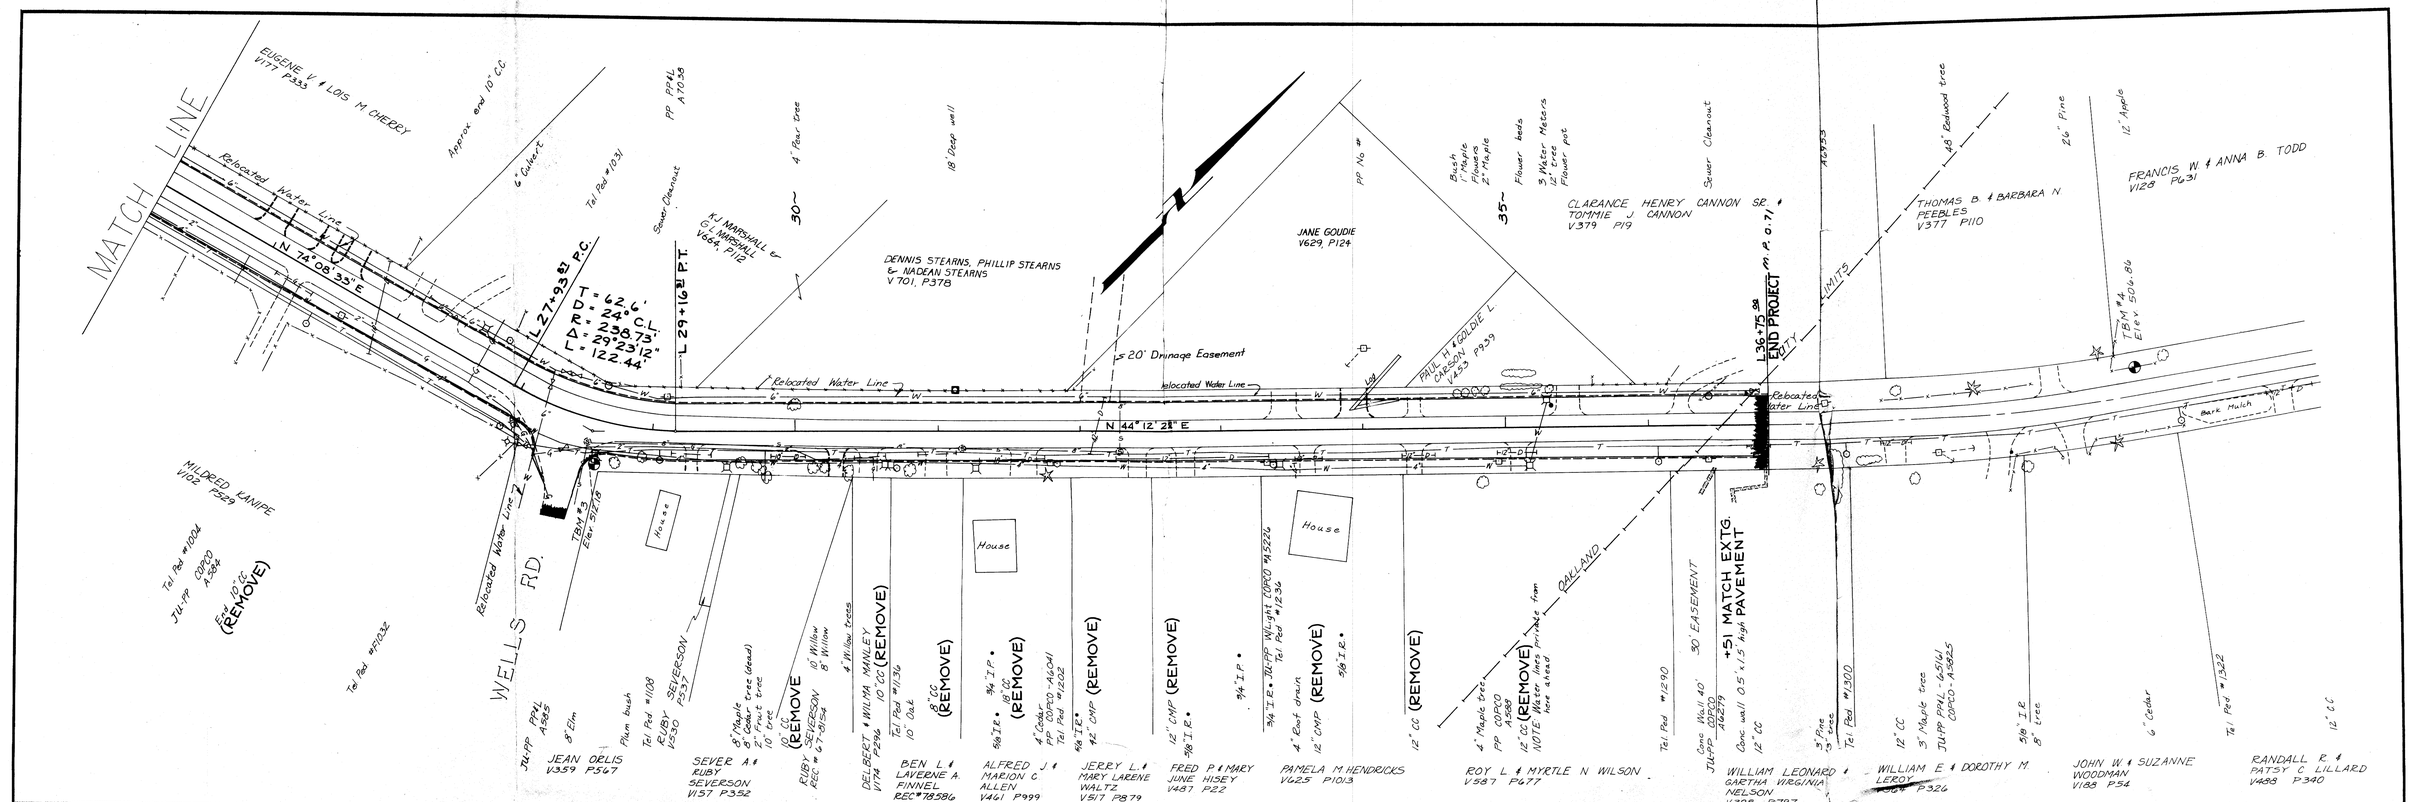

AS BUILT 8/10/79 L.L.

DOUGLAS COUNTY
PUBLIC WORKS DEPARTMENT
LOCUST ST. - OAKLAND
1979 SHT. 4
GEORGE E. GRUBB, DIRECTOR

SC06 1979-003