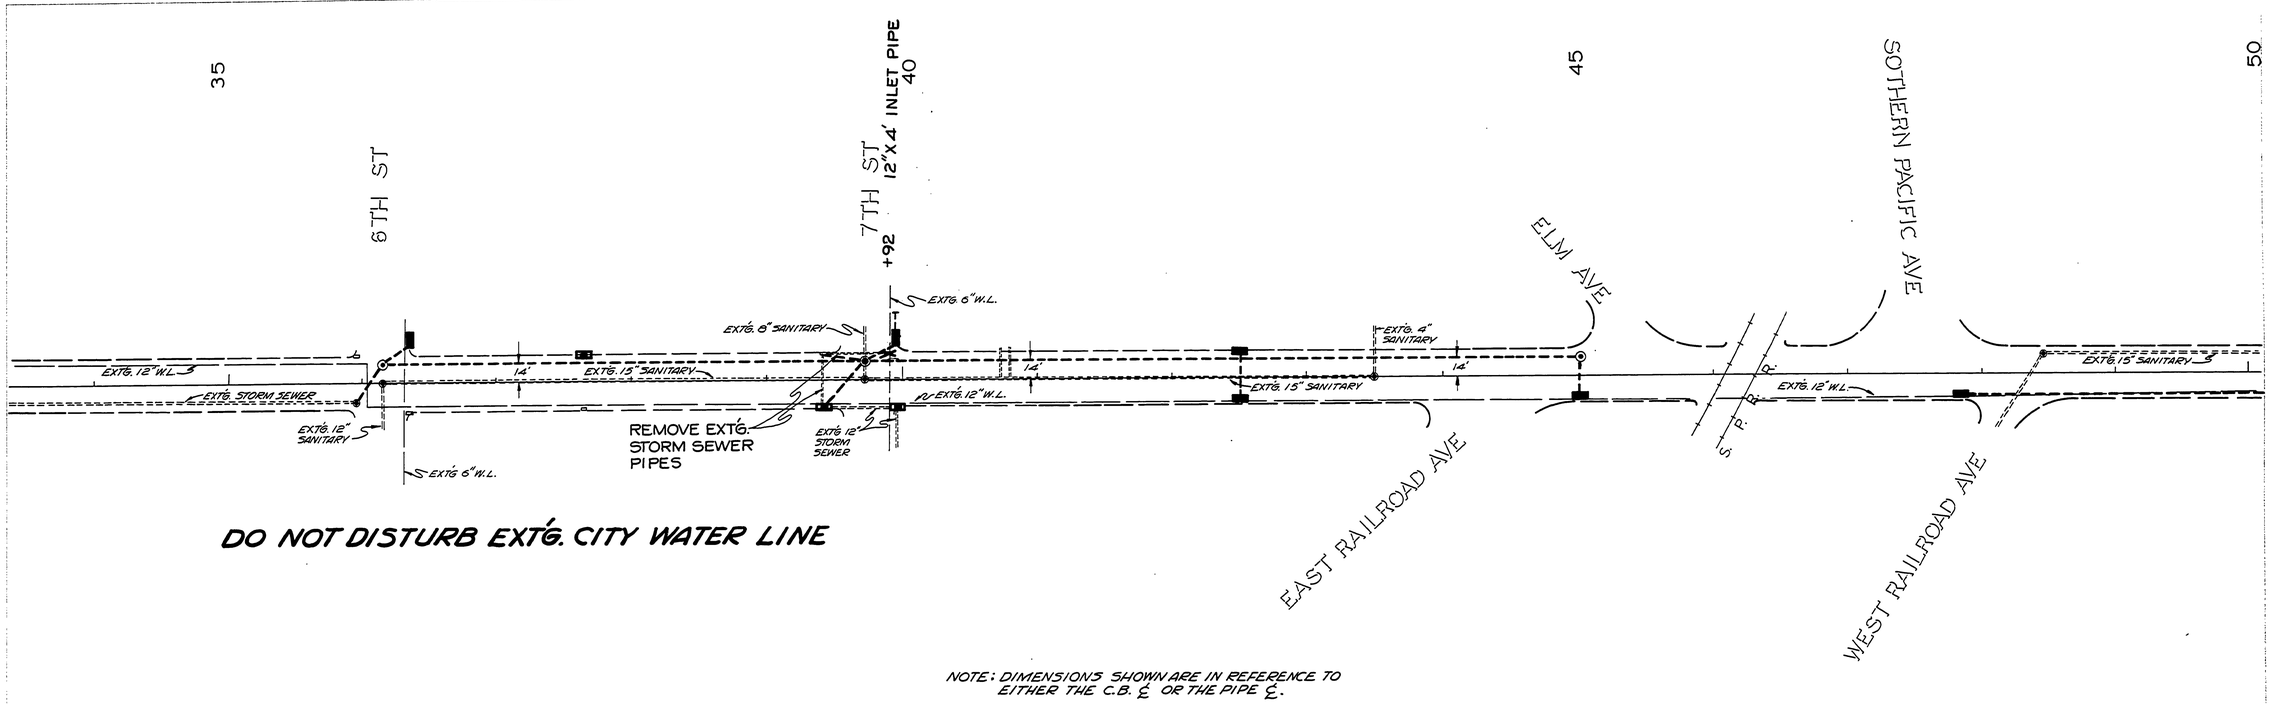

DO NOT DISTURB EXTG. CITY WATER LINE

NOTE: DIMENSIONS SHOWN ARE IN REFERENCE TO EITHER THE C.B. ℄ OR THE PIPE ℄.

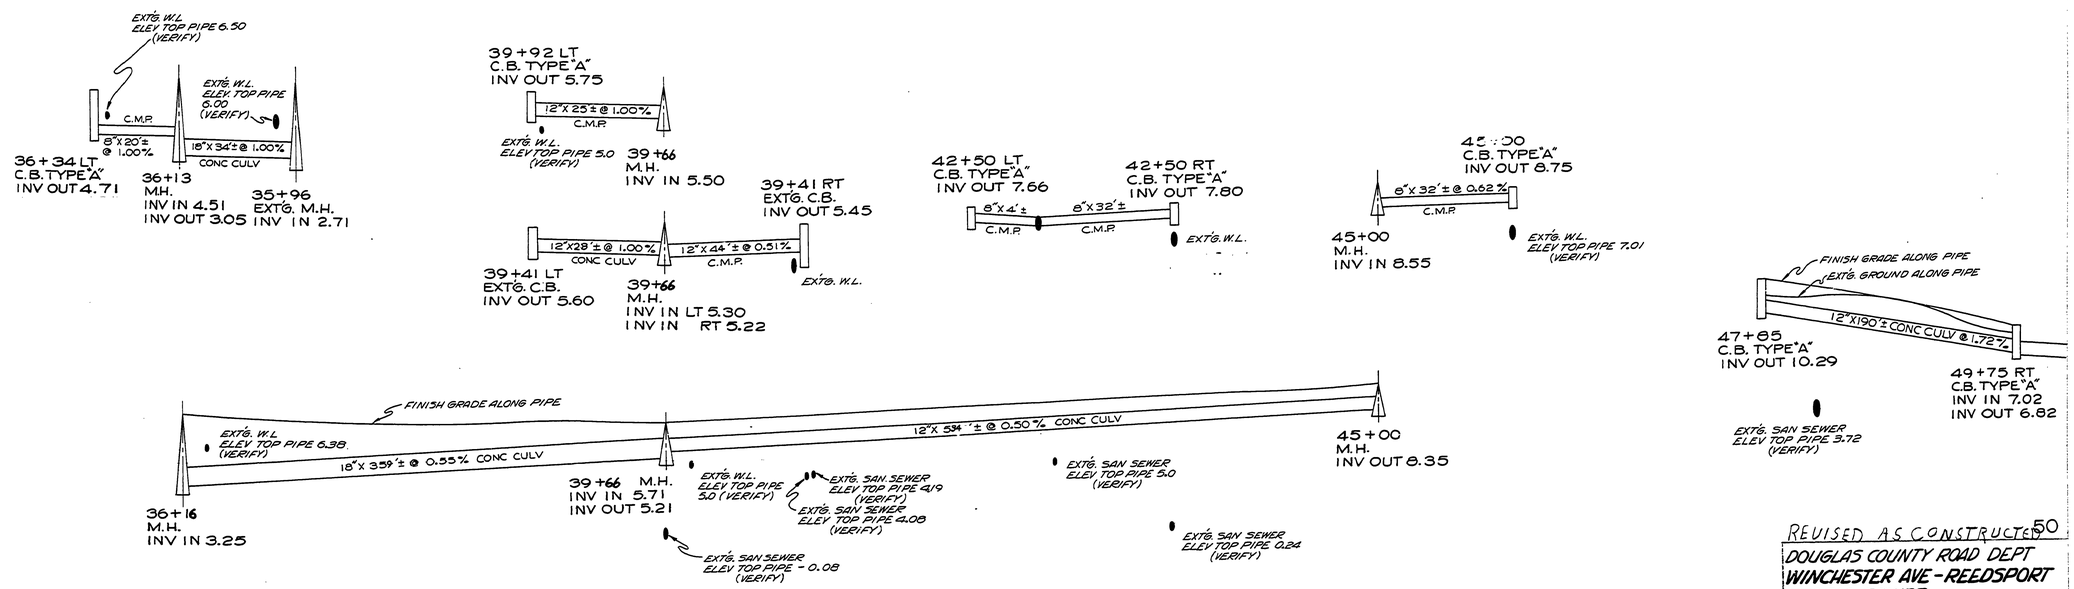

REVISED AS CONSTRUCTED

DOUGLAS COUNTY ROAD DEPT
WINCHESTER AVE - REEDSPORT STORM SEWER
APRIL 1971 SHT 10
GEORGE E. GRUBB COUNTY ENGR.