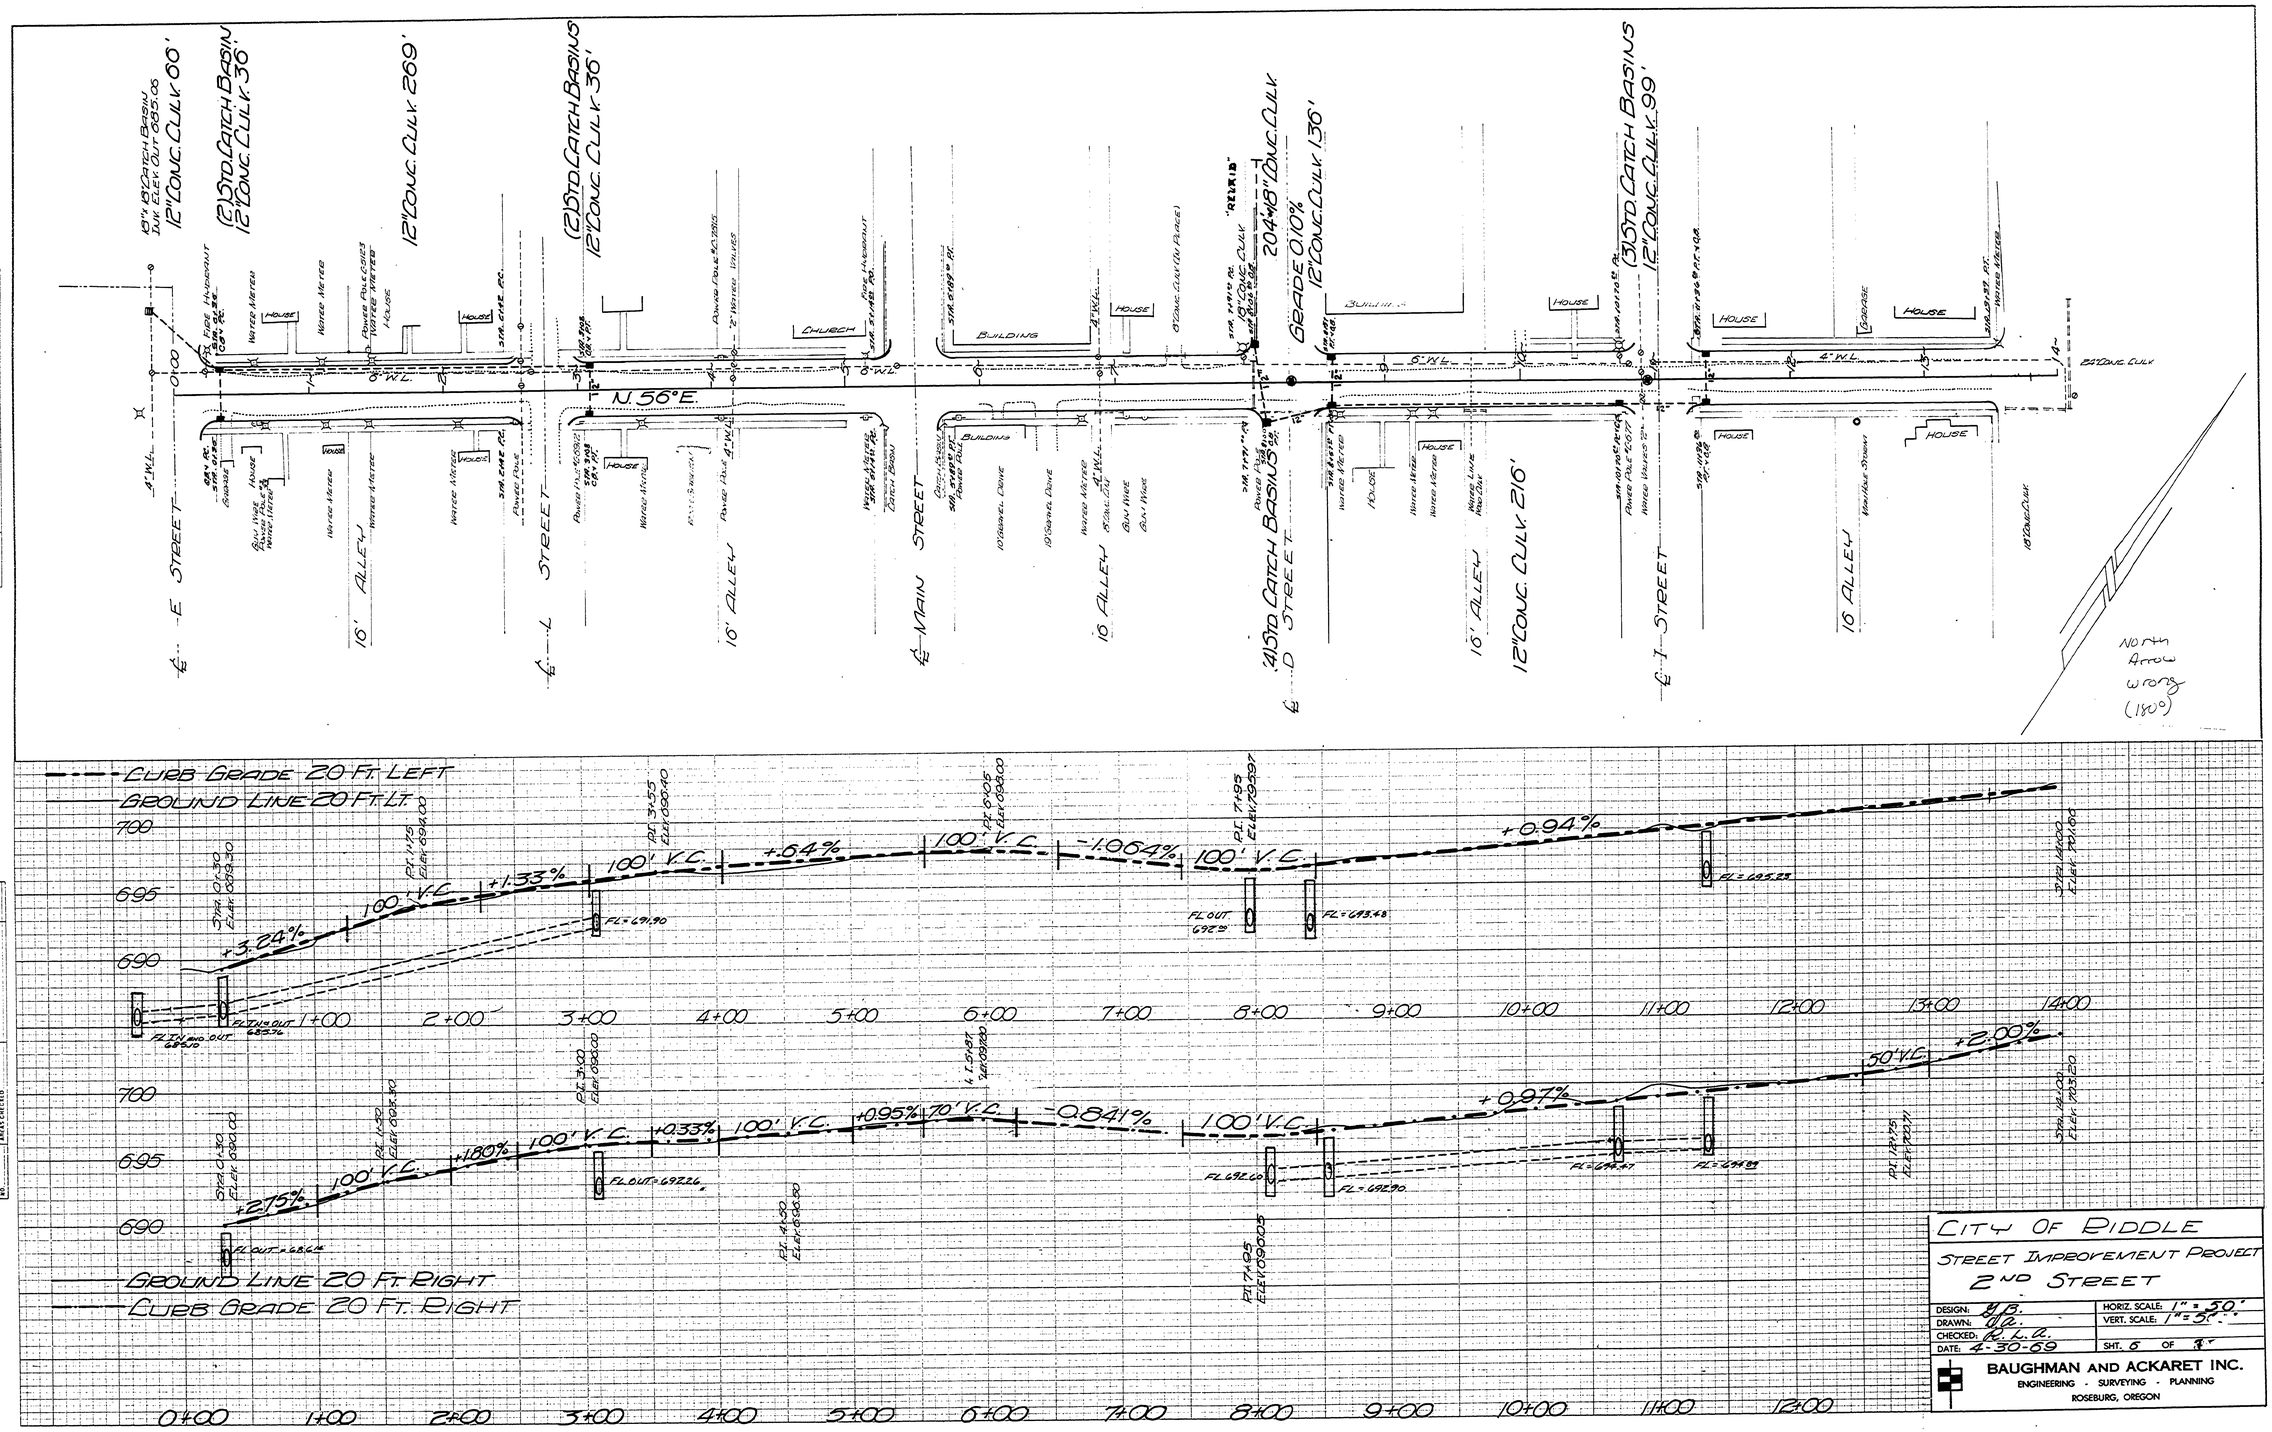

CITY OF PIDDLE

STREET IMPROVEMENT PROJECT

2ND STREET

DESIGN: H.B.	HORIZ. SCALE: 1" = 50'
DRAWN: D.A.	VERT. SCALE: 1" = 5'
CHECKED: H.L.A.	
DATE: 4-30-69	SHT. 6 OF 8

BAUGHMAN AND ACKARET INC.
ENGINEERING - SURVEYING - PLANNING
ROSEBURG, OREGON