Sec. 19 T.27S. R.5W. W.M.

JACKSON ST. TRIANGLE UTILITIES

LEGEND

- Sanitary Sewer
- Storm Sewer
- Water Line
- Gas Line
- Telephone Cable
- Telephone Pole
- Power Pole
- Manhole
- Catch Basin
- Water Meter
- Water Valve
- Fire Hydrant

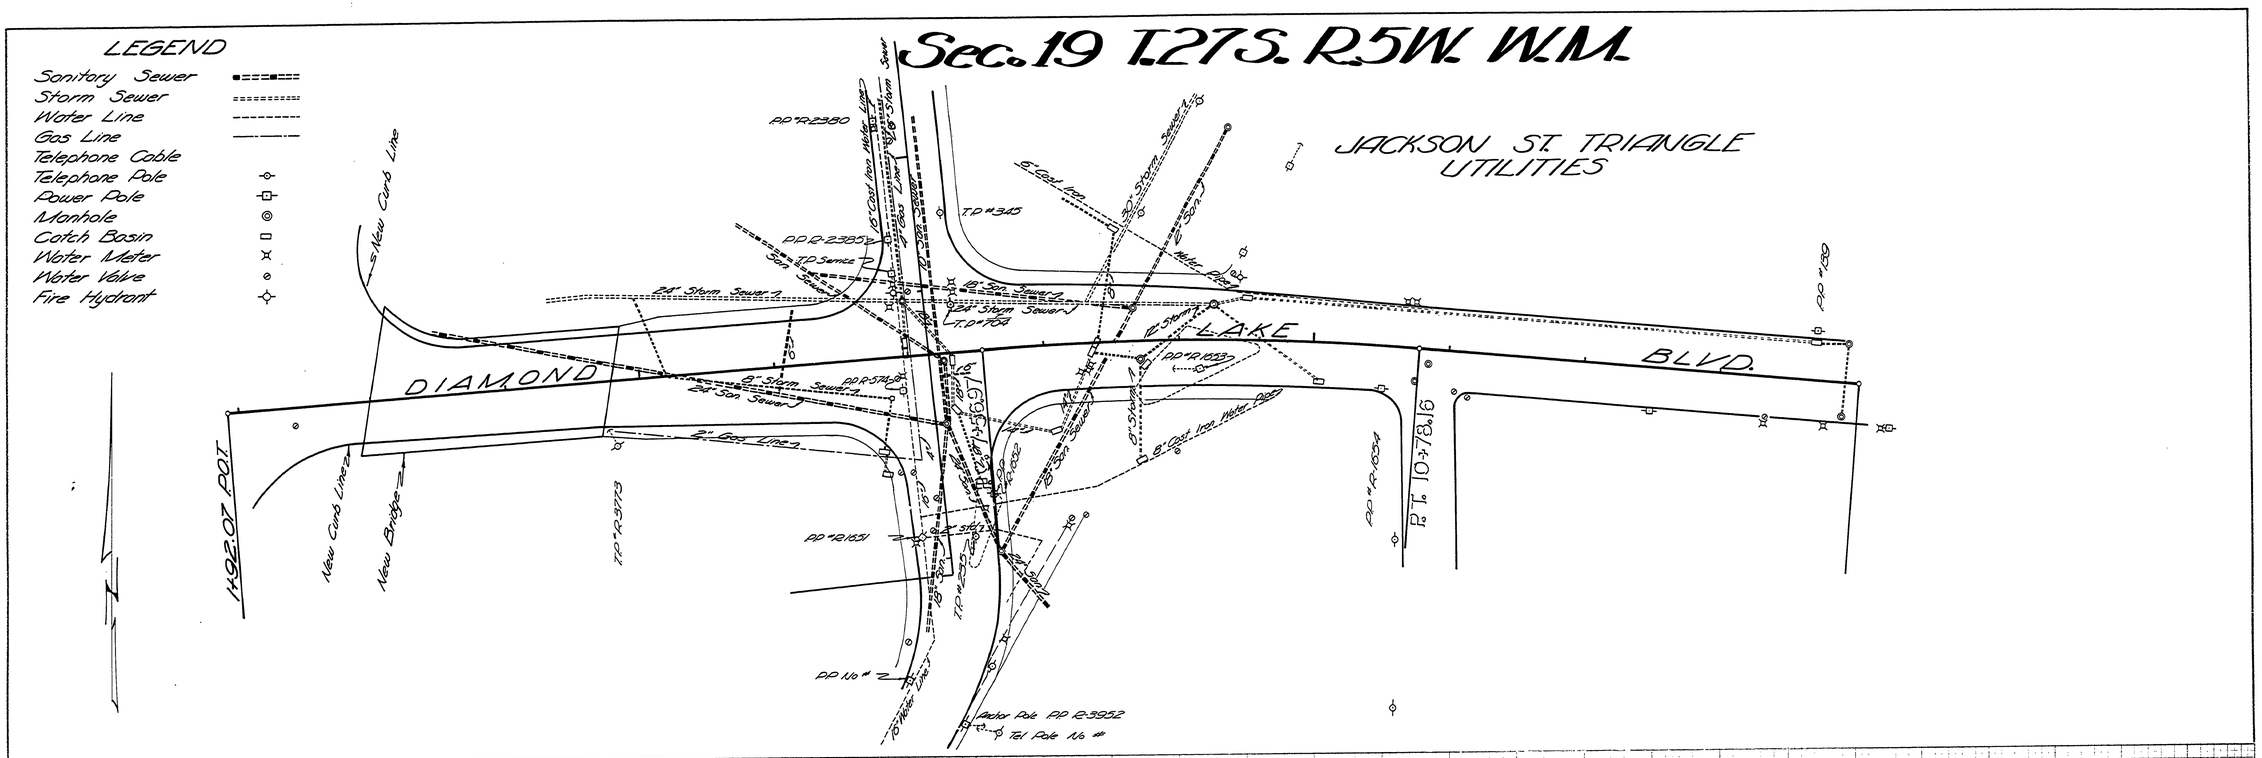

FINAL SURVEY	SURVEYED	BY	DATE
	PLOTTED		
	TEMPLATE		
	AREAS		
NOTE BOOK	AREAS CHECKED		
NO.			

ORIGINAL SURVEY	SURVEYED	BY	DATE
	PLOTTED		
	TEMPLATE		
	AREAS		
NOTE BOOK	AREAS CHECKED		
NO.			

FILED
RECEIVED
MAY 27 1969
COUNTY SURVEYOR
DOUGLAS COUNTY, ORE.

Douglas County Road Dept.
JACKSON ST.-TRIANGLE
Date 4-14-67 Sheet 2 of 5
GEORGE E. GAUGB County Engineer