JEFFERSON ST. STREET IMPROVEMENT PROJECT
STORM LINE

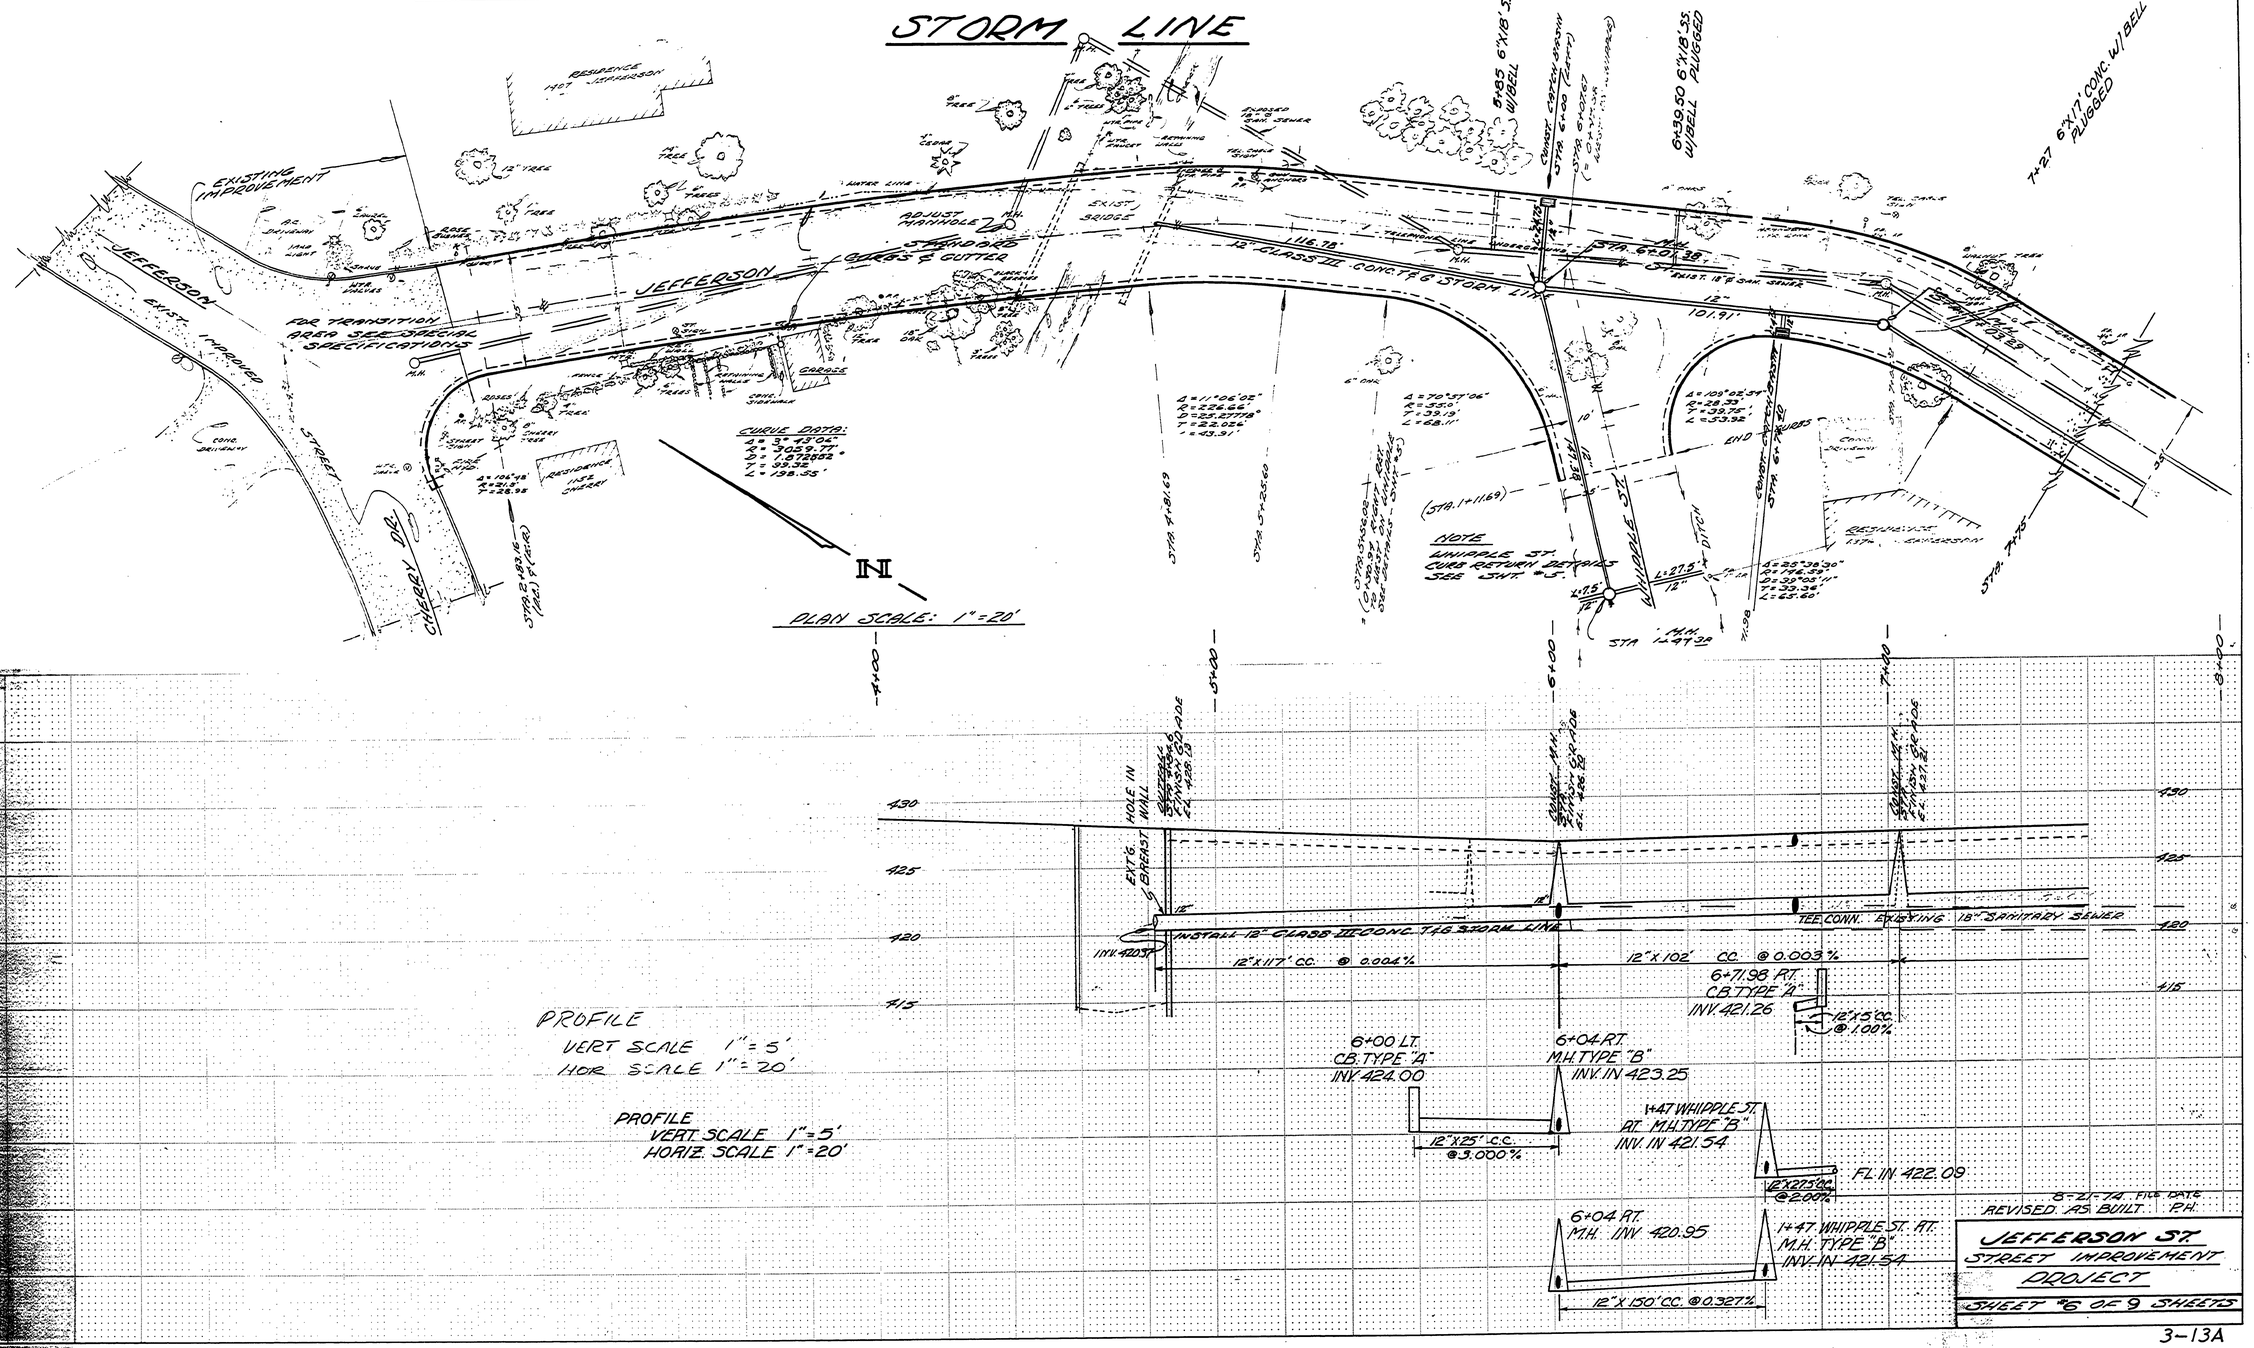

3-13A

SC09 1974-019

SC09 1974-019