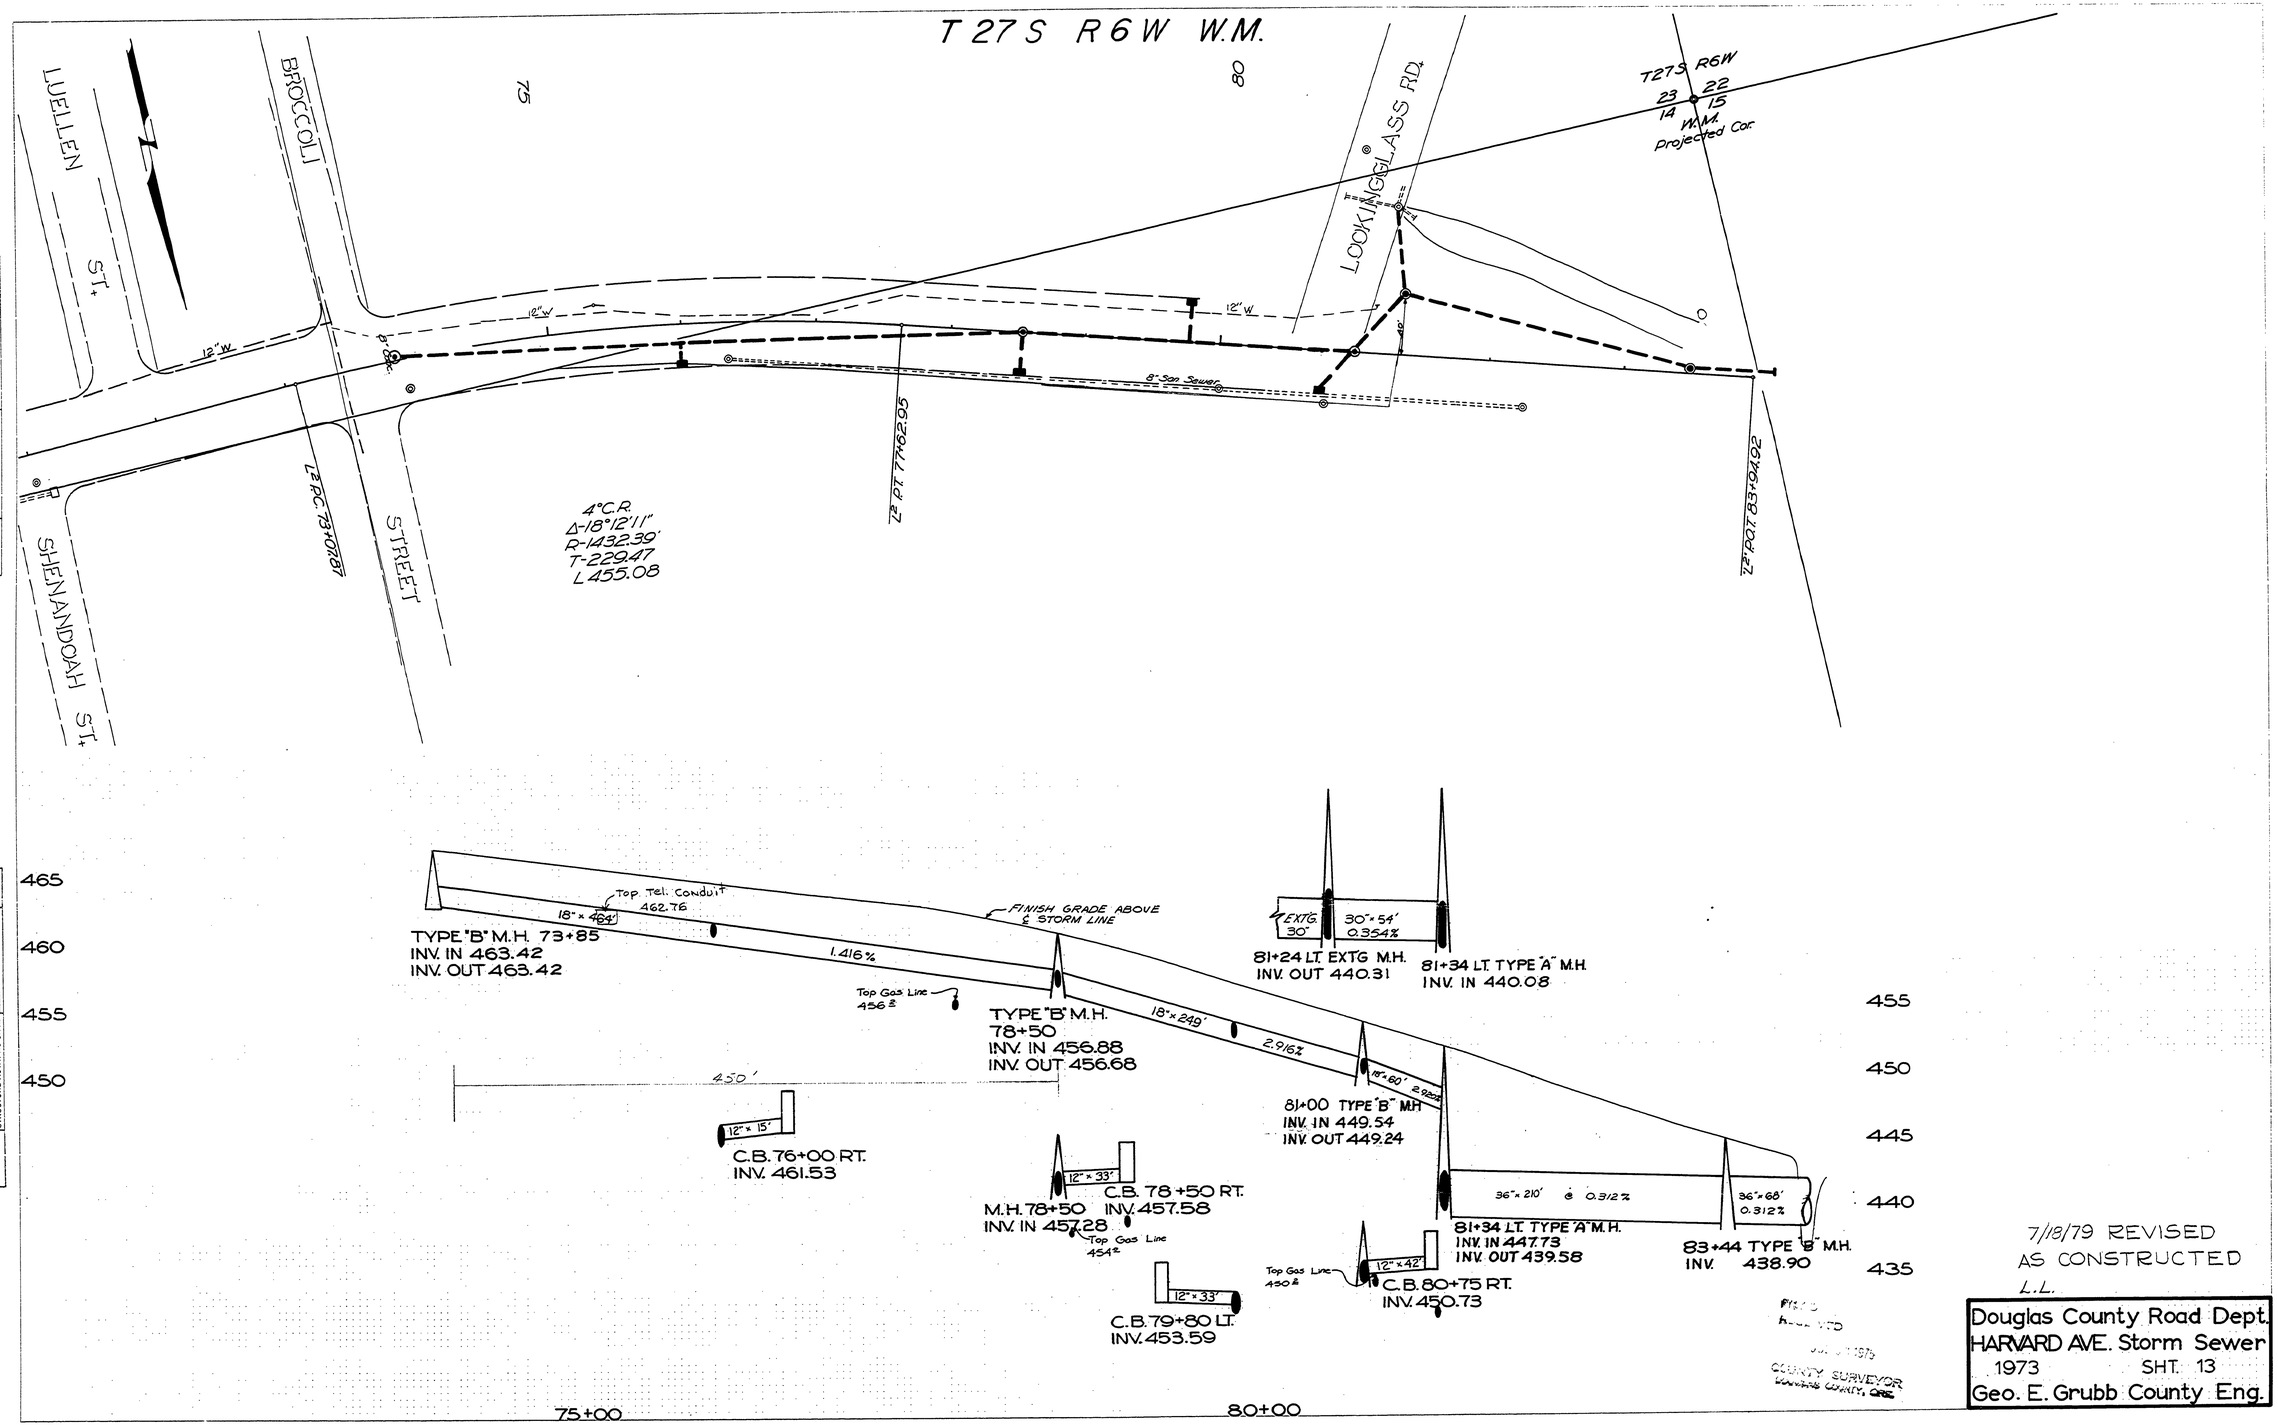

7/18/79 REVISED
AS CONSTRUCTED
L.L.

Douglas County Road Dept.
HARVARD AVE. Storm Sewer
1973 SHT. 13
Geo. E. Grubb County Eng.