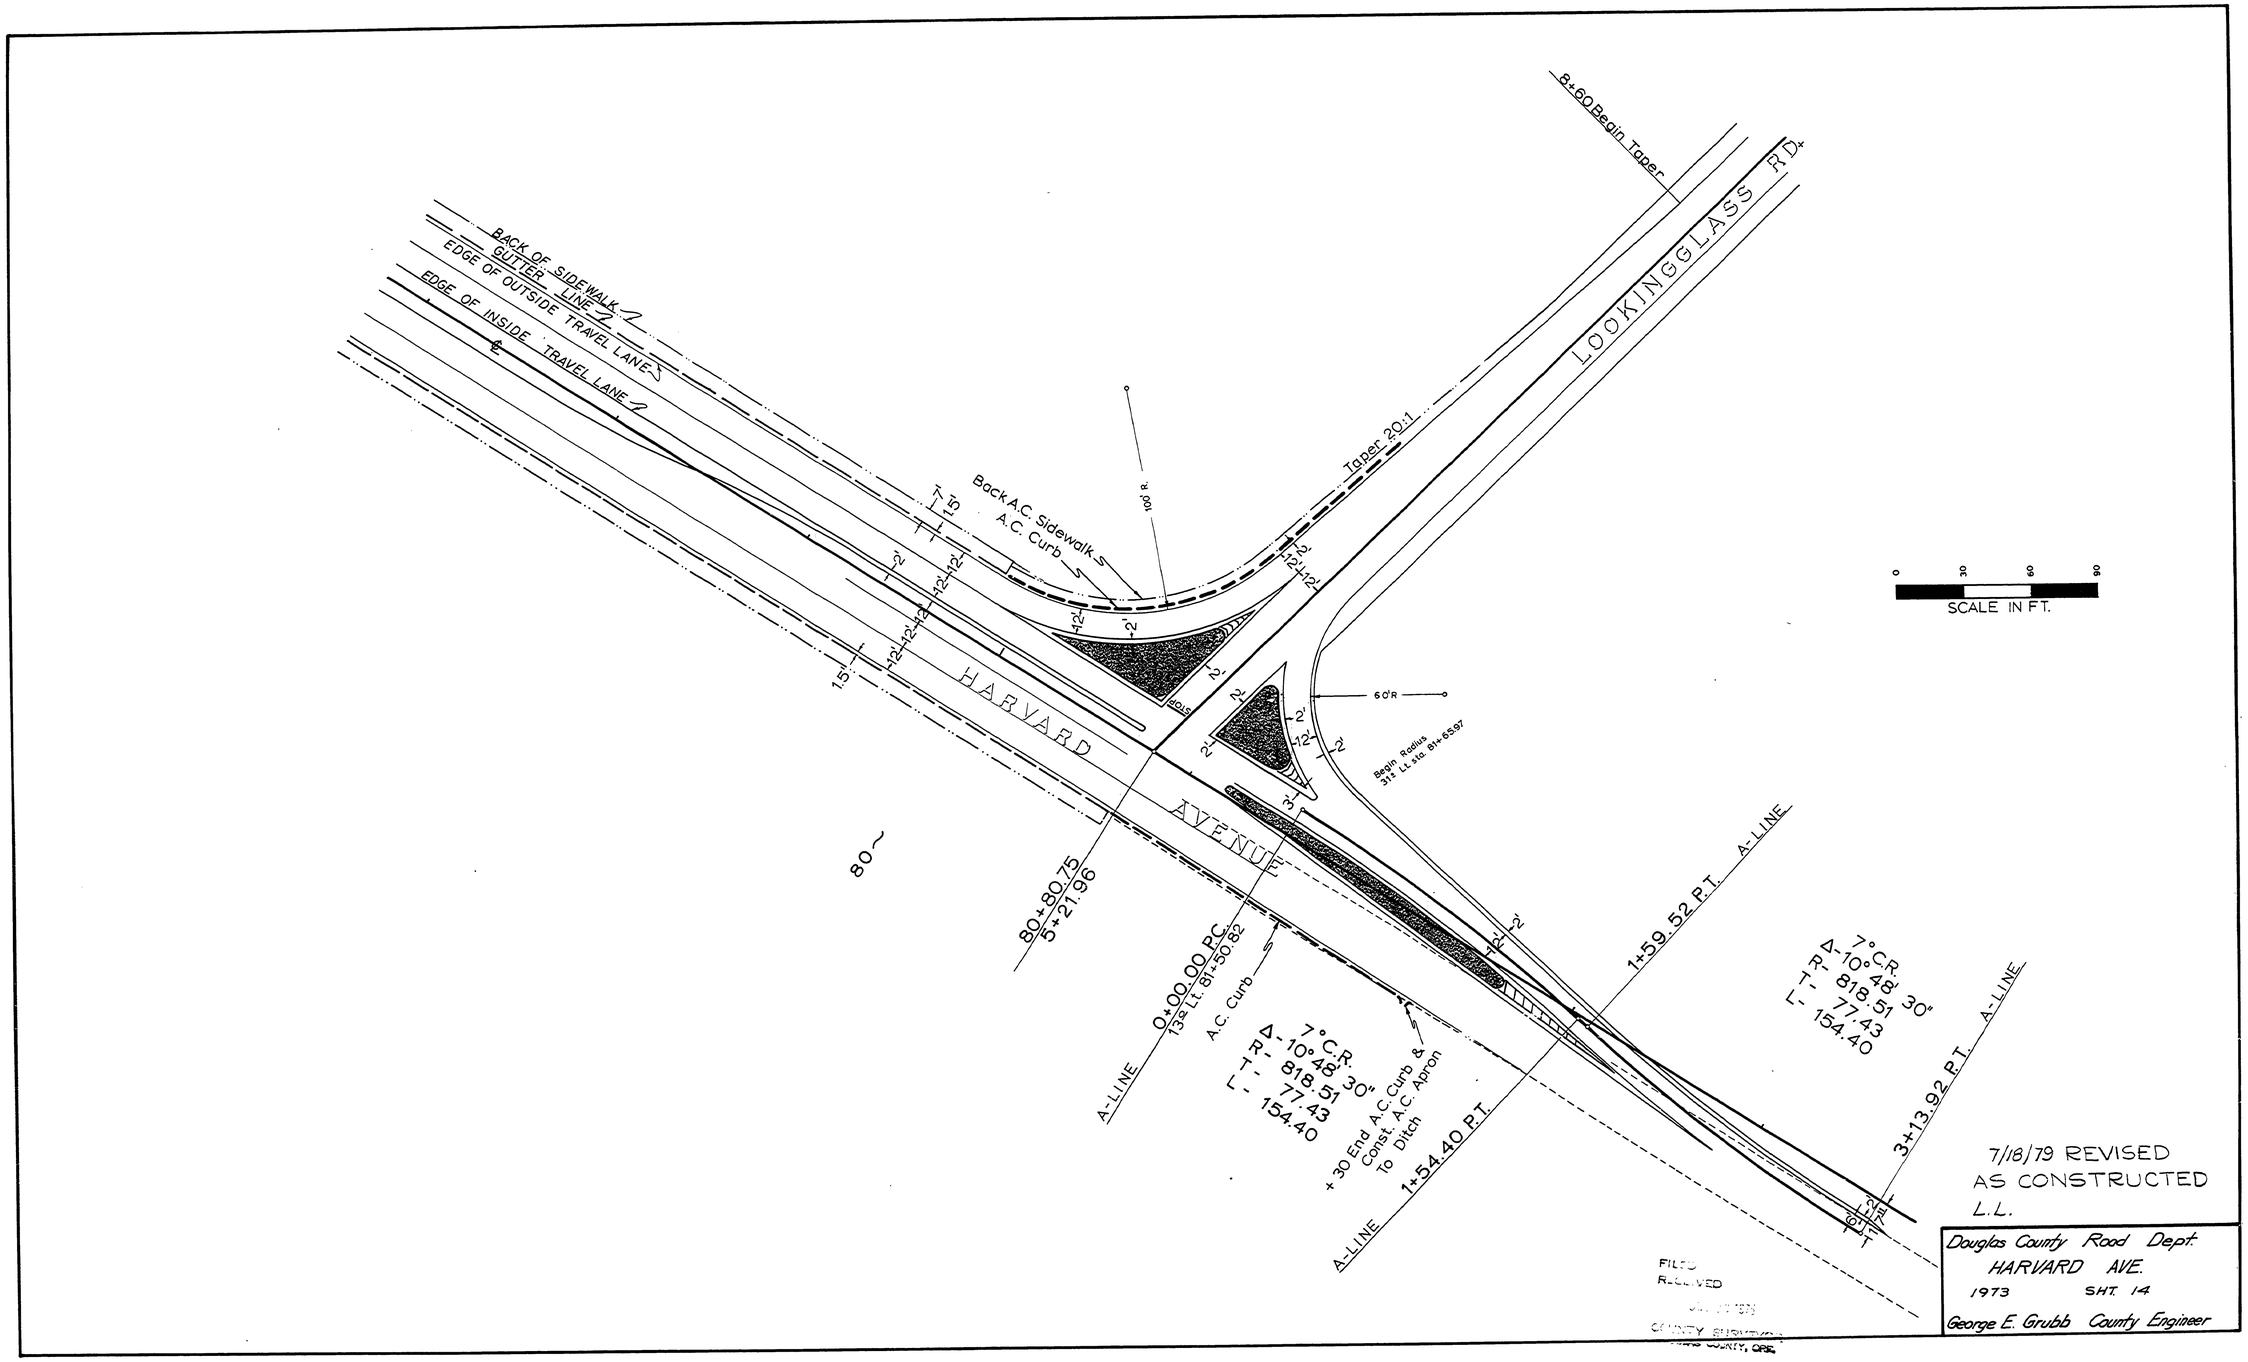
B+60 Begin Taper
LOOKINGGLASS RD.
BACK OF SIDEWALK
GUTTER LINE
EDGE OF OUTSIDE TRAVEL LANE
EDGE OF INSIDE TRAVEL LANE
Back A.C. Sidewalk
A.C. Curb
100' R.
Taper 20:1
HARVARD
AVENUE
60'R
Begin Radius
31± Lt. sta. 81+65.97
80+80.75
5+21.96
0+00.00 P.C.
13± Lt. 81+50.82
A.C. Curb
A-LINE
Δ - 7°
C.R. - 10°48' 30"
T.R. - 818.51
L - 77.43
154.40
+30 End A.C. Curb &
Const. A.C. Apron
To Ditch
1+54.40 P.T.
1+59.52 P.T.
3+13.92 P.T.
0 30 60 90
SCALE IN FT.
7/18/79 REVISED
AS CONSTRUCTED
L.L.
Douglas County Road Dept.
HARVARD AVE.
1973 SHT. 14
George E. Grubb County Engineer
FILED
RECEIVED
COUNTY SURVEYOR
DOUGLAS COUNTY, ORE.