SC09 1978-050

DOUGLAS COUNTY, OREGON

PLANS FOR PROPOSED PROJECT
GRADING, SURFACING, STORM
DRAIN, & SANITARY SEWER

CANTERBURY ESTATES SUBDIVISION

—1976—

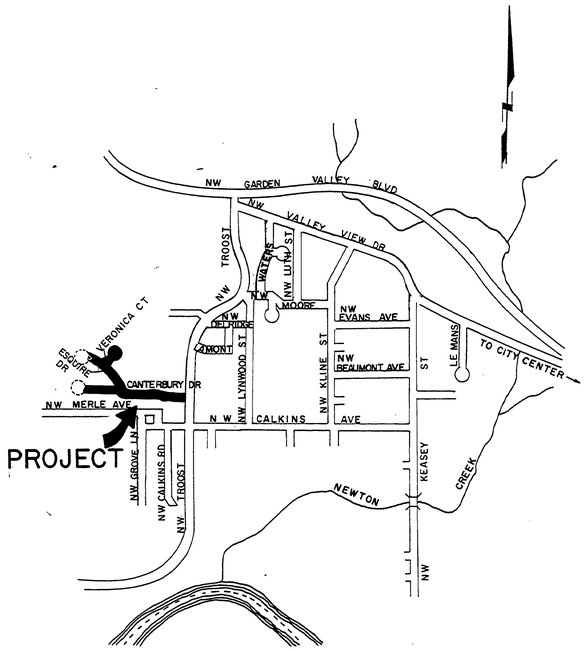

ROSEBURG

TYPICAL SECTION

"V" LINE – STA. 10+84.38 TO 11+40

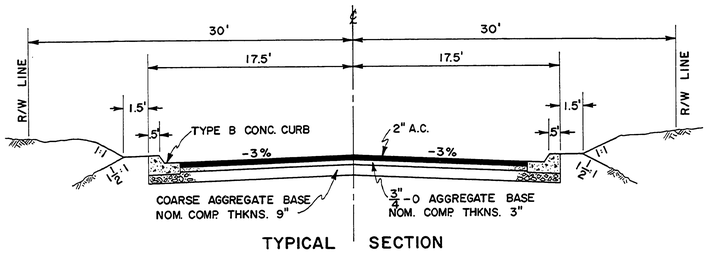

TYPICAL SECTION

"C" LINE – STA. 9+81.5 TO 12+00
TRANSITION – STA. 12+00 TO 13+50

"E" LINE – STA. 11+50 TO 14+96.37

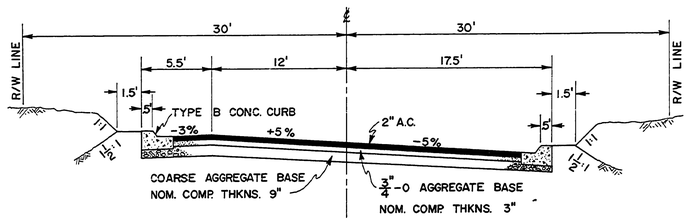

TYPICAL SECTION

"C" LINE – STA. 13+50 TO 19+69.08

"V" LINE – STA. 10+45.70 TO 10+49.41

TRANSITION – STA. 10+49.41 TO 10+84.38

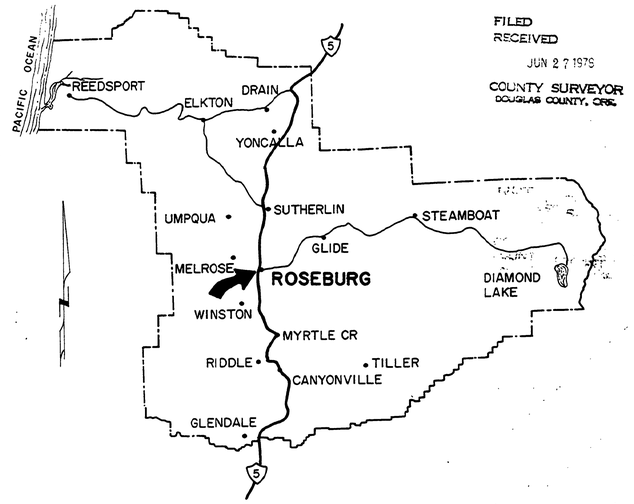

FILED
RECEIVED
JUN 27 1978
COUNTY SURVEYOR
DOUGLAS COUNTY, ORE.

INDEX OF DRAWINGS

SHEET NO.	DESCRIPTION
1	COVER SHEET
2	QUANTITY SUMMARY
3	ROAD PLANS
4	CUL-DE-SAC PLANS
5	STORM DRAIN

STANDARD DRAWINGS
110, 310, 3 & 9

6 & 7 SANITARY SEWER PLANS

11 SHEETS TOTAL

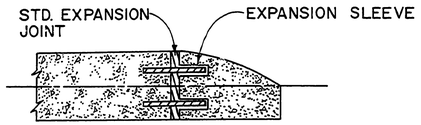

TYPICAL SECTION FOR CURB ENDS

AT
STA. "C" 19+17
STA. "E" 14+43

AS CONSTRUCTED
6-7-78 RHP

REGISTERED PROFESSIONAL ENGINEER
OREGON
MAY 2, 1978
GEORGE E. GRUBB

SURVEYED	JL
DESIGNED	RBA
DRAFTED	JW
REVIEWED	2/24/78
BOOK	

DOUGLAS COUNTY
PUBLIC WORKS DEPARTMENT
CANTERBURY ESTATES SUBDIV.
1976 SHT. 1
GEORGE E. GRUBB, DIRECTOR

MADE MICROFILM/PRECISION GRAPHICS

SC09 1978-050