SC09 1978-059

S10 & 11, T.27S, R.6W, WM.

FILED
RECEIVED
JUN 29 1978
COUNTY SURVEYOR
DOUGLAS COUNTY, ORE.

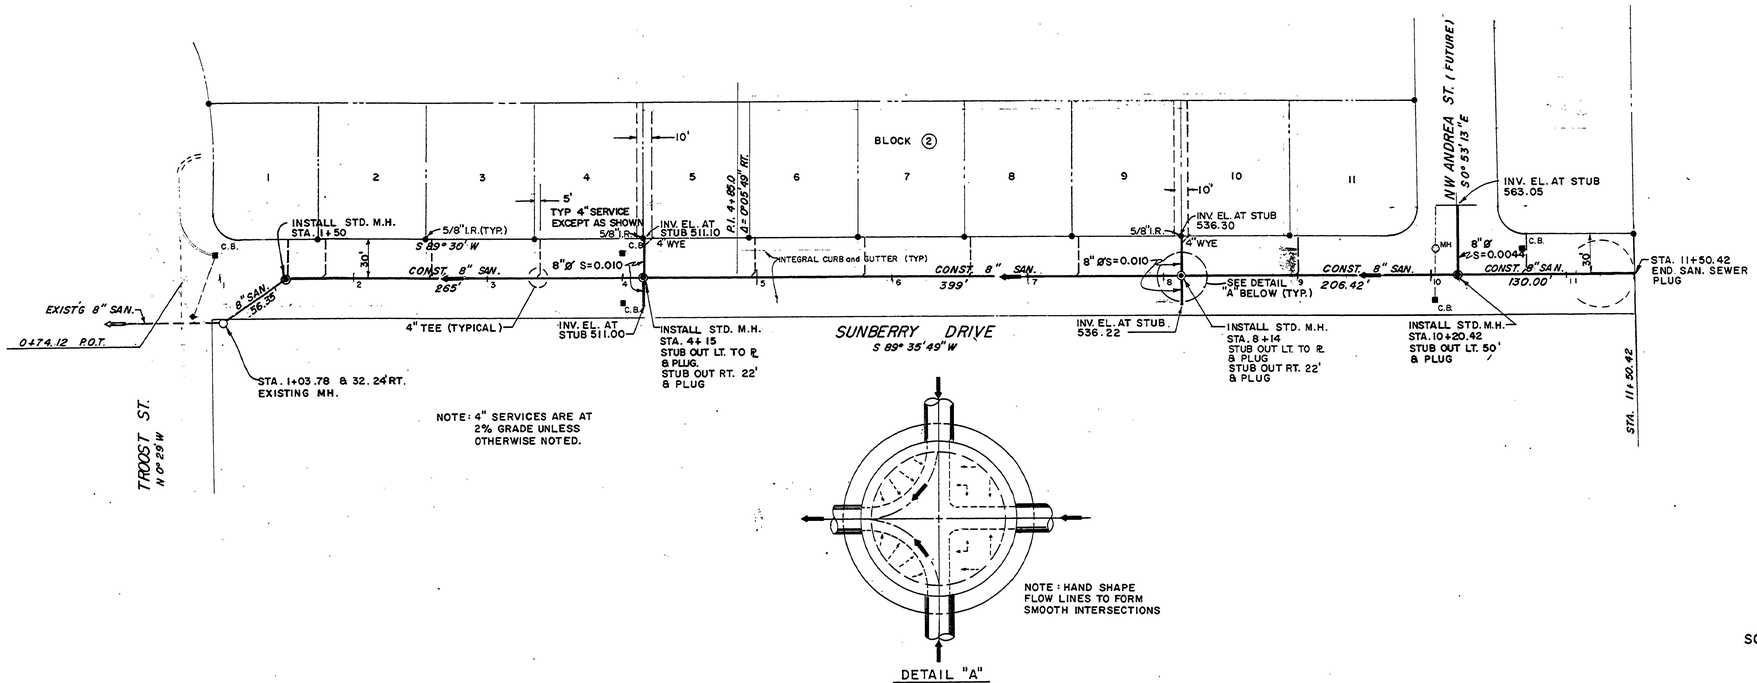

DETAIL "A"
NO SCALE

SCALE: HORIZ. 1" = 50'
VERT. 1" = 5'

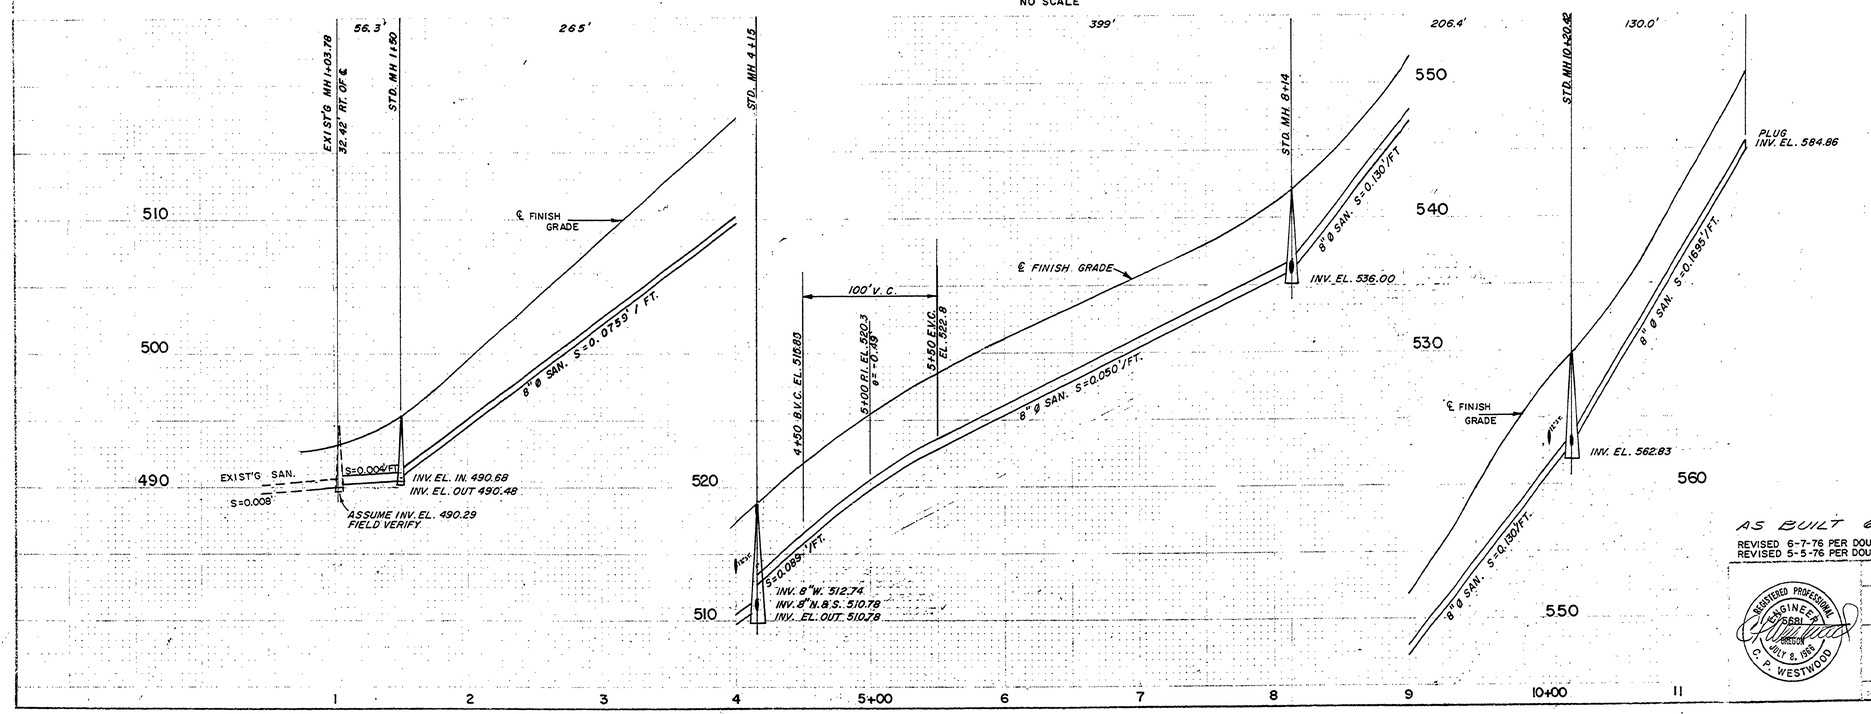

AS BUILT 6-29-78 R.U.F.

REVISED 6-7-76 PER DOUGLAS CO. PLAN CHECK OF 6-3-76 piw
REVISED 5-5-76 PER DOUGLAS CO. PLAN CHECK OF 4-27-76 piw

REGISTERED PROFESSIONAL ENGINEER 6681 OREGON JULY 8, 1975 C. P. WESTWOOD

DOUGLAS COUNTY PUBLIC WORKS DEPARTMENT
GEORGE E. GRUBB, DIRECTOR

SUNBERRY DRIVE
SANITARY SEWER IMPROVEMENTS

C & G ENGINEERING
P.O. BOX 222
ROSEBURG, OREGON

SHEET 10 | 5
36250

G.D. | RE/PW | NOTED | DATE 3/25/76

PLATE: PLAN-PROFILE (PPN STANDARD)

SC09 1978-059

PLAN
NOTE BOOK
No.

PROFILE
NOTE BOOK
No.