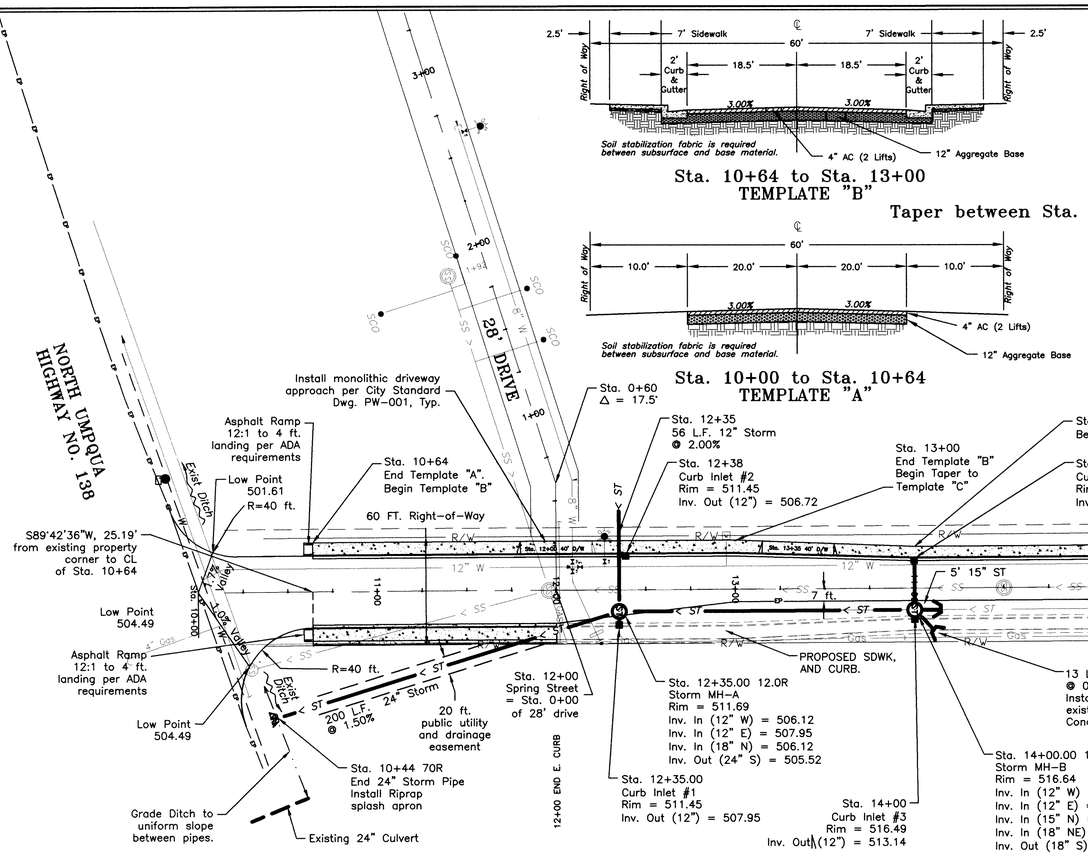

Sta. 10+64 to Sta. 13+00
TEMPLATE "B"

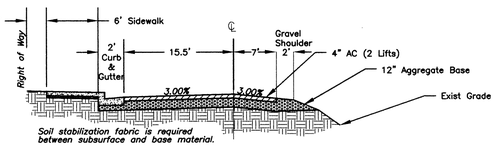

Sta. 14+00 to Sta. 18+00
TEMPLATE "C"

Taper between Sta. 13+00 and Sta. 14+00

Sta. 10+00 to Sta. 10+64
TEMPLATE "A"

LEGEND

PROPOSED		EXISTING
(SS)	SANITARY SEWER MANHOLE	(SS)
(ST)	STORM SEWER MANHOLE	
▤	CATCH BASIN	
✱	FIRE HYDRANT	
✱	GATE VALVE	
☼	STREET LIGHT BASE	
—10" W—	WATER LINE	—8" W—
— ST > —	STORM DRAIN	—SD—
— SS > —	SANITARY SEWER	—SS—
——⊐	END CAP (WATER)	
-	THRUST BLOCK	
SCO●	SANITARY CLEANOUT	
—G—	GAS LINE	—G—
—UP—	UNDERGROUND POWER	—UP—
—T—	TELEPHONE LINE	—T—
═══	CURB & GUTTER	
[W]	WATER METER	
	PROPERTY LINE	—P/L—
	RIGHTS-OF-WAY	—R/W—
	EASEMENT BOUNDARY	— — —
	EDGE OF PAVEMENT	— EP —
	EDGE OF GRAVEL	— EG —
	CORNER PIN	○ ●

FILED
Date: 11-2-2006 By: JP
This survey consists of:
Map: SC09 2003-073
Narrative:
Corner Rpt:
DOUGLAS COUNTY SURVEYOR

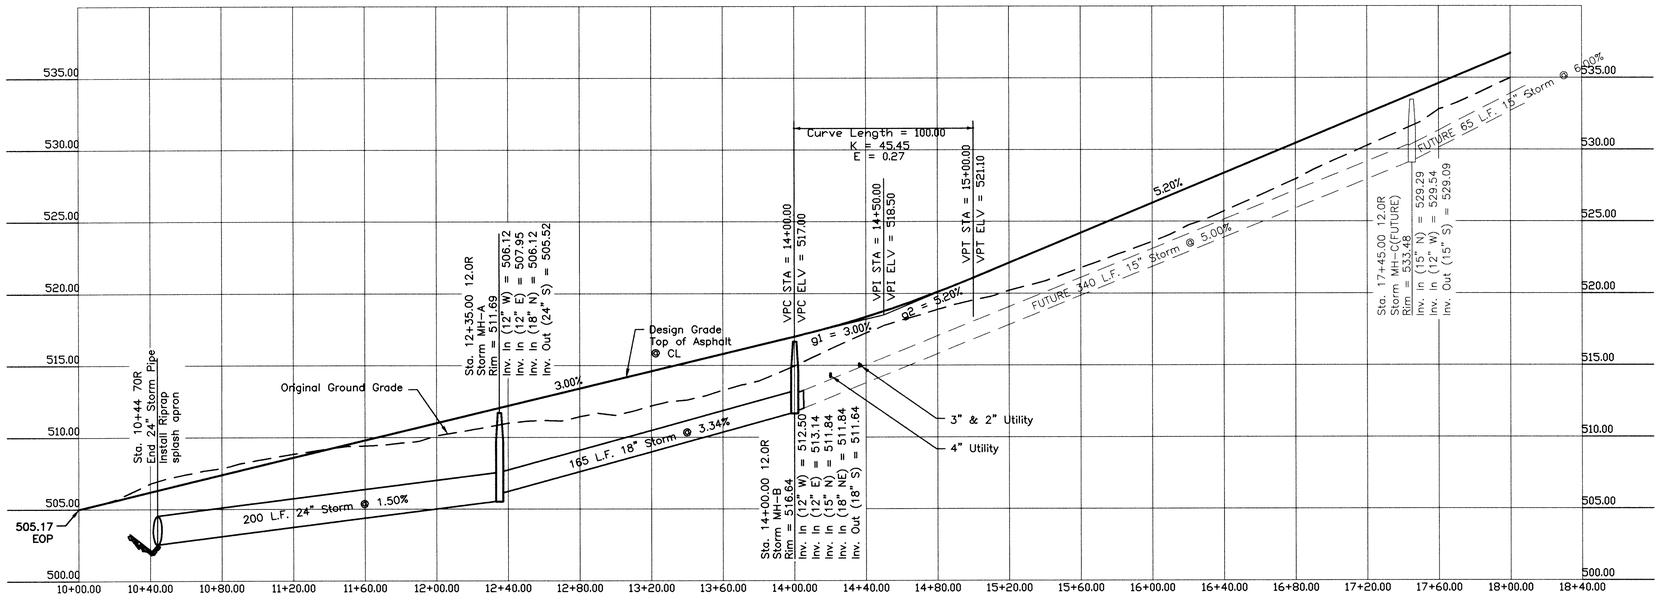

ATTENTION : OREGON LAW REQUIRES YOU TO FOLLOW RULES ADOPTED BY THE OREGON UTILITY NOTIFICATION CENTER. THOSE RULES ARE SET FORTH IN OAR 952-001-0010 THROUGH 952-001-0090. YOU MAY OBTAIN COPIES OF THE RULES BY CALLING THE CENTER AT 1-800-332-2344. CALL BEFORE YOU DIG.

CITY PUBLIC WORKS INSPECTION SCHEDULE
THE CITY OF ROSEBURG SHALL BE NOTIFIED FOR INSPECTION AT LEAST 24 HOURS PRIOR TO THE ACCOMPLISHMENT OF THE FOLLOWING STAGES OF CONSTRUCTION (PHONE: 672-7701 FAX: 672-2785):

1. ANY STORM SEWER CONSTRUCTION (INCLUDING STRUCTURES).
2. FINISHED SUB-GRADE (PRIOR TO FABRIC INSTALLATION).
3. SOIL STABILIZATION FABRIC INSTALLATION.
4. ALL CONCRETE WORK.
5. FINISHED BASE COURSE GRADE
6. PAVING.

NONE OF THE ABOVE ITEMS OF WORK SHALL BE COVERED UNTIL INSPECTED BY THE CITY OF ROSEBURG PUBLIC WORKS DEPARTMENT.

REGISTERED PROFESSIONAL ENGINEER
OREGON
JULY 17, 1981
RICHARD E. HUTTON
11.1.17
EXPIRES: 6-30-03

SURVEYING & ENGINEERING, INC.
ENGINEERING • SURVEYING • PLANNING
3079 NE DIAMOND LAKE BLVD.
ROSEBURG, OREGON 97470
TEL (541)672-2096
FAX (541)672-0611

Revision	FOR CONST.	Revision	
Date	7-24-01	Date	
Revision	AS BUILT	Revision	
Date	1-07-03	Date	

Drawn	MPS
Design	DH
Checked	HP
Reviewed	DH

DATE: 12/01/00

TITLE: ROAD DESIGN & STORM SYSTEM

PROJECT NAME: POMONA STREET IMPROVEMENT PROJECT

AA# 2339.2

SHT. 2 OF 6

SC09 2003-073