SCII 1978-007

S21T28SR6W W.M.

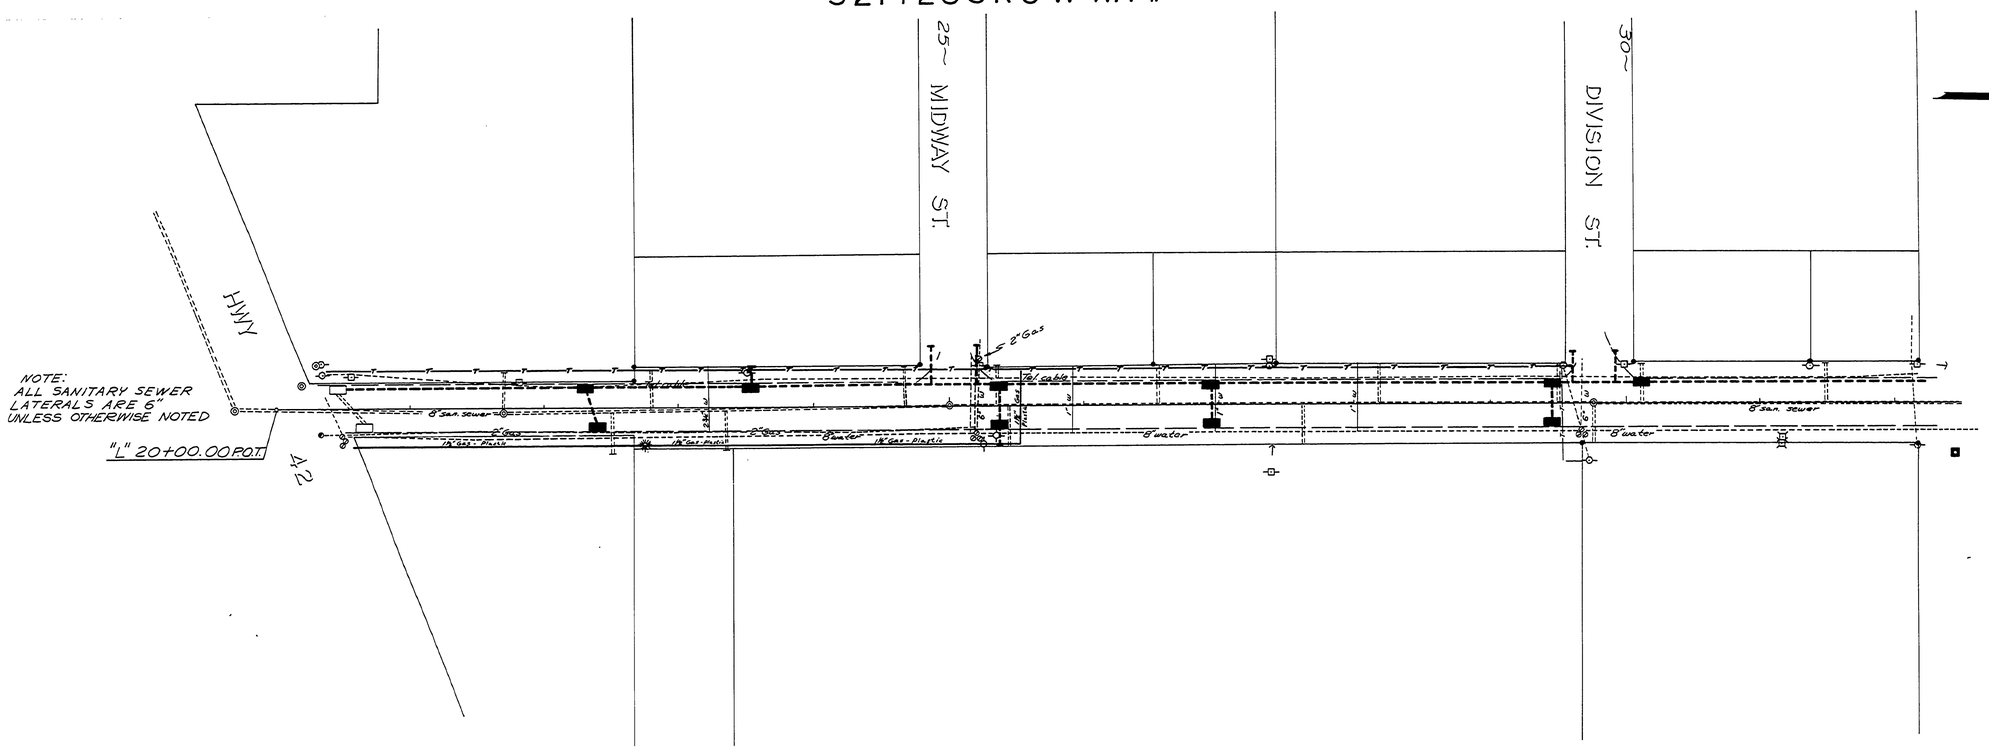

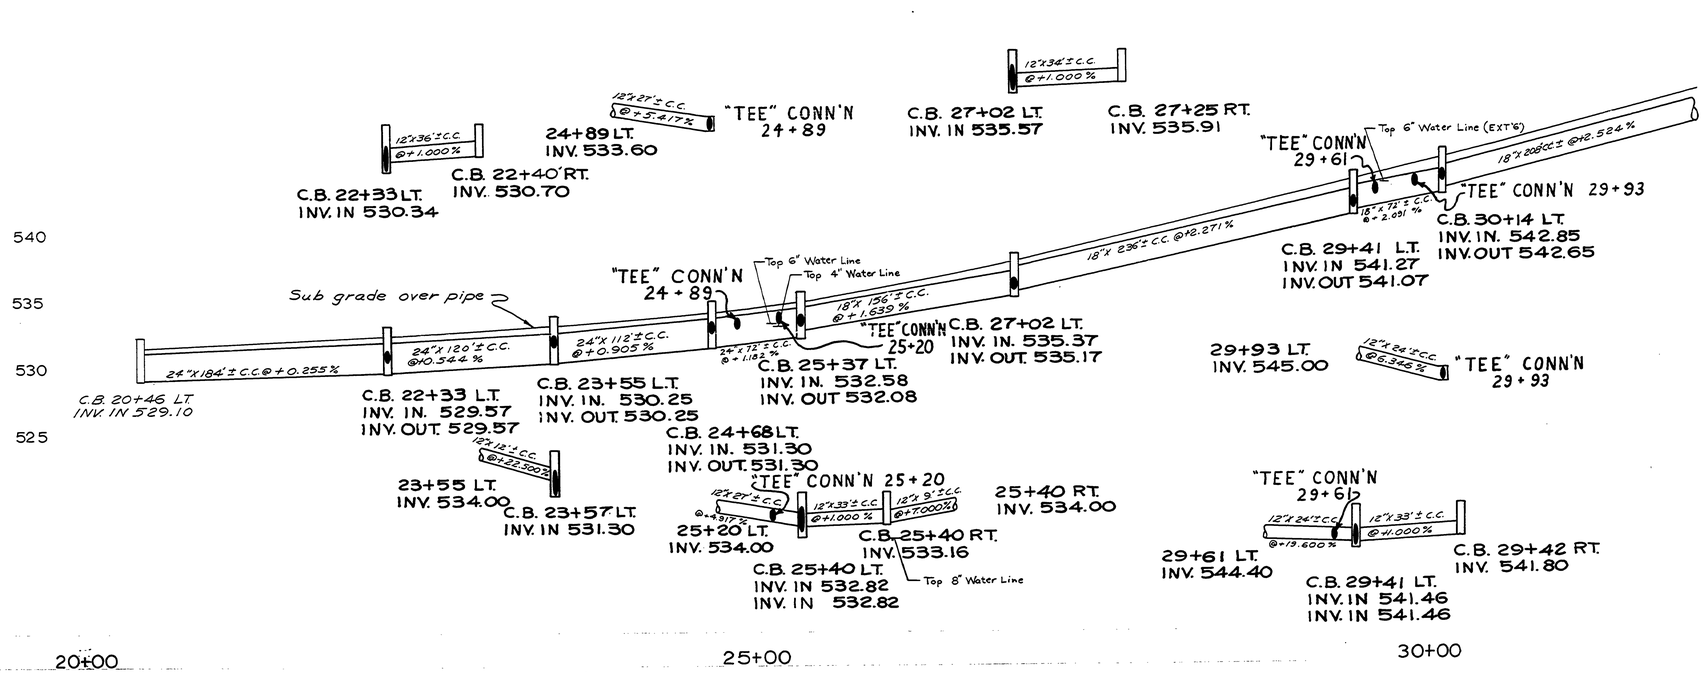

AS BUILT 10-10-78 TV

DOUGLAS COUNTY
PUBLIC WORKS DEPARTMENT
GLENHART AVE.

1975 SHT. 5

GEORGE E. GRUBB, DIRECTOR

SCII 1978-007