PLAN		BY	DATE
NOTE BOOK	SURVEYED		
	PLOTTED		
	ALIGNMENT CHECKED		
NO.	RT OF WAY CHECKED		

25

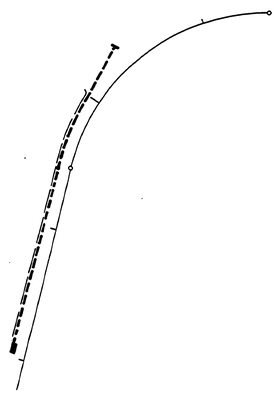

PROFILE		BY	DATE
	SURVEYED		
	PLOTTED		
NOTE BOOK	GRADES CHECKED		
	B.M. NOTED		
NO.	STRUCTURE NOTES CHECKED		

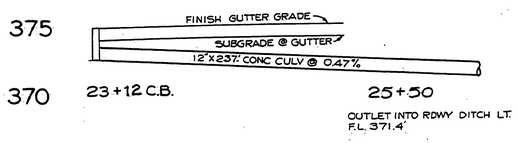

AS CONSTRUCTED B.B.B.

DOUGLAS COUNTY ROAD DEPT.
FIRST ST-YONCALLA
MAY 1971 SHT 7
GEORGE E. GRUBB COUNTY ENGR.