

OFFICE OF THE
DOUGLAS COUNTY SURVEYOR


6-002
95-D

210 124 84

NSD
50

970775.82
484811.17

3970708.48
1812 5133"

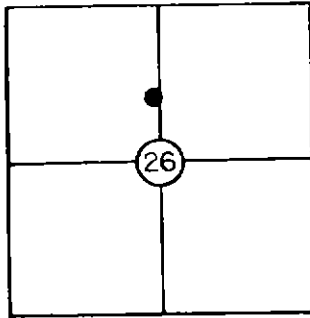

T 21 S, R 12 W, Sec. 26

Station: 95B

Set By (Agency): DCSO

Date: 1980

VERTICAL CONTROL

Elevation: _____ NGS(USC&GS) Line # _____ USGS Line # _____

Order
Of Precision _____ Agency: _____ Proj. #: _____ Date: _____

HORIZONTAL CONTROL


Oregon State Plane Coordinates: Y(Northing) 770,114.43 X(Easting) 1,050,022.84
(South Zone)

Order
Of Precision 1/20,000 Agency: DCSO Proj. #: 6010-5 Date: 1980

Approximate Geographic Position: Latitude= _____ Longitude= _____

DESCRIPTION: A 5/8" iron rod 30" long with
aluminum cap stamped "95B" set flush with
ground. Power Pole TR1 2 4 A bears
N 69° W, 1.5 ft.

SKETCH

 

VICINITY: Approx. 1 mile N. of Reedsport on
ridge SE of Gardiner.

NOTE: For Possible Further Information On This Station, Please Contact The Douglas County Surveyors Office, Rm. 205 Douglas County Justice Bldg., Roseburg, OR. 97470 Phone 672-3311 Ext. 272. Douglas County residents outside the Roseburg calling area dial toll free 1-800-452-0991.