OFFICE OF THE
DOUGLAS COUNTY SURVEYOR

Station: SW COR. SEC. 5 T 22 S, R 12 W, Sec 5

Set By (Agency): DCSO

200600

Date Set: 1967

Recovered By GEQ

Date Recovered 6/83

Recovered By

Date Recovered

Recovered By

Date Recovered

220-12W-05-010 22S 12W 05
SW CORNER

NAD	755920.10	3952254.86
83	43°40'57"	124° 9'52"

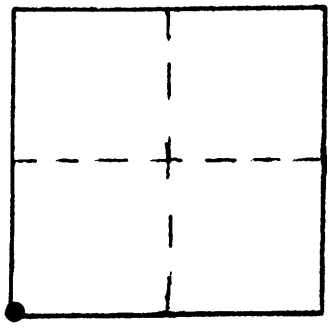

VERTICAL CONTROL

Elevation: _____ NGS Line # _____ USGS Line # _____ OSHD Line # _____

Precision: _____ Agency: _____ Proj. # _____ Date: _____

HORIZONTAL CONTROL NAD 27

South Zone State Plane Coordinates: Y(Northing) 755,955.17 X(Easting) 1,031,294.14

Precision: 1/5,000 Agency: DCSO Proj. # 6004-16 Date: 1983

Approximate Geographic Position: Latitude 43°40'58" Longitude 124°09'47"

DESCRIPTION and TO REACH

SKETCH

DESCRIPTION:

A brass cap. See Douglas County
Surveyor's Records of Government Cor.
Renewed.

Reference Marks:

Note: For further information, contact the Douglas County Surveyor's Office, Room 205 Douglas County Justice Building, Roseburg, OR 97470. Phone 440-4278. Douglas County residents outside the Roseburg calling area, dial toll free 1-800-452-0991.