OFFICE OF THE
DOUGLAS COUNTY SURVEYOR

Station: W 1/16 12/13 T 22 S, R 13 , Sec 13

620500

Set By (Agency): DCSO

Date Set: 1/14/88

Recovered By

Date Recovered

Recovered By

Date Recovered

Recovered By

Date Recovered

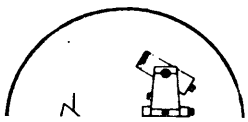

220-13W-13-054 22S 13W 13
W 1/16 12/13

NAD	751093.11	3942913.58
83	43°40' 6"	124°11'56"

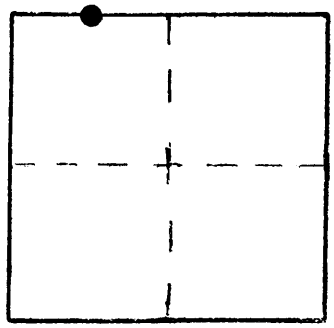

VERTICAL CONTROL

Elevation: NGS Line # USGS Line # OSHD Line #

Precision: Agency: Proj. # Date:

HORIZONTAL CONTROL NAD 27

South Zone State Plane Coordinates: Y(Northing) 751,128.18 X(Easting) 1,021,952.84

Precision: 1/5000 Agency: DCSO Proj. # 6008-8 Date: 1988

Approximate Geographic Position: Latitude 43°40'06" Longitude 124°11'51"

DESCRIPTION and TO REACH

SKETCH

3" brass cap set in concrete bell tile.
Iron placed inside bell tile for future magnetic detection.

See Douglas County Surveyor's Records of Government Corners.

Reference Marks:

Note: For further information, contact the Douglas County Surveyor's Office, Room 205 Douglas County Justice Building, Roseburg, OR 97470. Phone 440-4278. Douglas County residents outside the Roseburg calling area, dial toll free 1-800-452-0991.