

OFFICE OF THE
DOUGLAS COUNTY SURVEYOR

Station: SE Cor

T 23 S, R 5W , Sec 11

Date Set: 1954

Set By (Agency): RE#2741

Date Recovered: 12/6/90



Recovered By: RWS,SJF,TF

Date Recovered: _____

Recovered By: _____

Date Recovered: _____

Recovered By: _____

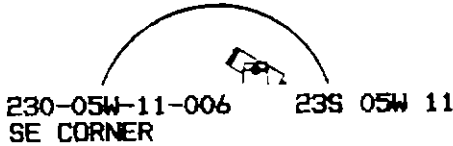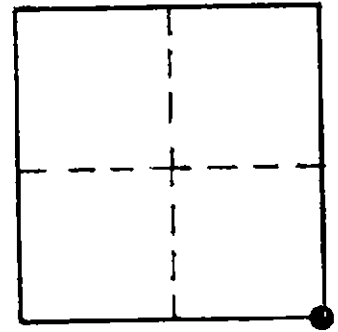

NAD 708191.92 4193458.15
83 43°34'38" 123°14'49"

VERTICAL CONTROL

Elevation: _____ NGS Line # _____ USGS Line # _____ OSHD Line # _____

Precision: _____ Agency: _____ Proj. # _____ Date: _____

HORIZONTAL CONTROL

South Zone O.C.S. 27: Y(Northing) 708,226.65 X(Easting) 1,272,497.82

South Zone O.C.S. 83: Y(Northing) _____ X(Easting) _____

Precision: 1/5000 Agency: DCSO Proj. # 2015 Date: 1990

Approx. NAD 83 Geographic Position: Latitude _____ Longitude _____

DESCRIPTION and TO REACH

SKETCH

See DCSO corner renewal records.

Reference Marks:

Note: For further information, contact the Douglas County Surveyor's Office, Room 205 Douglas County Justice Building, Roseburg, OR 97470. Phone 440-4278. Douglas County residents outside the Roseburg calling area, dial toll free 1-800-452-0991.