

OFFICE OF THE
DOUGLAS COUNTY SURVEYOR

Station: NW Cor. DLC 47

T 25 S, R 4 W, Sec 7

Set By (Agency): DCSO

PLSS 047020

Date Set: 1965

Recovered By _____



Date Recovered _____

Recovered By _____

Date Recovered _____

Recovered By _____

Date Recovered _____

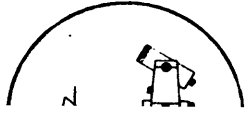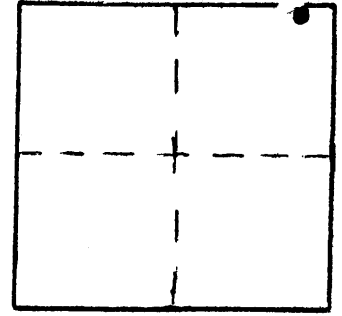

250-04W-07-008 255 04W 07
NW CORNER DLC 47

NAD 649687.23 4201823.32
83 43°25' 3" 123°12'30"

VERTICAL CONTROL

Elevation: _____ NGS Line # _____ USGS Line # _____ OSHD Line # _____

Precision: _____ Agency: _____ Proj. # _____ Date: _____

HORIZONTAL CONTROL *NAD 27*

South Zone State Plane Coordinates: Y(Northing) 649,722.29 X(Easting) 1,280,863.11

Precision: 1/25,000 Agency: DCSO Proj. # 2004-17 Date: 1979

Approximate Geographic Position: Latitude 43°24'39" Longitude 123°28'41"

DESCRIPTION and TO REACH

SKETCH

* See Douglas County Surveyor's record of Government corners renewed.

Reference Marks:

Note: For further information, contact the Douglas County Surveyor's Office, Room 205 Douglas County Justice Building, Roseburg, OR 97470. Phone 440-4278. Douglas County residents outside the Roseburg calling area, dial toll free 1-800-452-0991.