

OFFICE OF THE
DOUGLAS COUNTY SURVEYOR

PLSS 440700

Station: N 1/4 T 25 S, R 5W, Sec 3

Set By (Agency): DCSO

Date Set: 1957

Recovered By _____


Date Recovered 1980

Recovered By _____

Date Recovered _____

Recovered By _____

Date Recovered _____

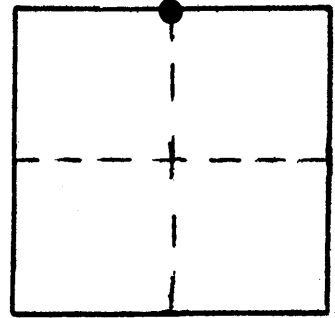

250-05W-03-013 25S 05W 03

N 1/4

NAD 655603.22 4183771.36
83 43°25'55" 123°16'37"

VERTICAL CONTROL

Elevation: _____ NGS Line # _____ USGS Line # _____ OSHD Line # _____

Precision: _____ Agency: _____ Proj. # _____ Date: _____

HORIZONTAL CONTROL NAD 27

South Zone State Plane Coordinates: Y(Northing) 655,637.82 X(Easting) 1,262,811.70

Precision: 1/5000 Agency: DCSO Proj. # 2006 ^{Calapooya} Date: 1981

Approximate Geographic Position: Latitude 43°25'56" Longitude 123°16'33"

DESCRIPTION and TO REACH

SKETCH

See Douglas County Surveyors records of government corners renewed.

Reference Marks:

Note: For further information, contact the Douglas County Surveyor's Office, Room 205 Douglas County Justice Building, Roseburg, OR 97470. Phone 440-4278. Douglas County residents outside the Roseburg calling area, dial toll free 1-800-452-0991.