


OFFICE OF THE
DOUGLAS COUNTY SURVEYOR

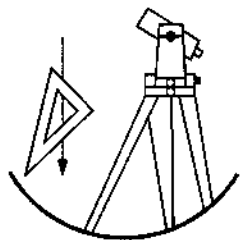

Station: WC TO SW COR. 100200

T27S R6W Sec. 30

Date Set: 1993

Set By (Agency): DCSO

DCSO Designation: 270-06W-30-027

Date Recovered: 6/8/93


Recovered By: RWS,SJF

Date Recovered: _____

Recovered By: _____

Date Recovered: _____

Recovered By: _____

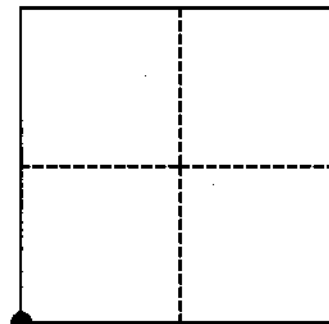

VERTICAL CONTROL

NGVD 29 Elevation: 636.3 FEET NAVD 88 Elevation: _____ METERS

NGS Line # _____ USGS LINE # _____ OSHD Line # _____ FILE # _____

Precision: GPS Agency: DCSO Proj: 0001 Date: 1993

HORIZONTAL CONTROL

O.C.S. 27 Y(Northing): 567,759.83 O.C.S. 83 Y(Northing): 567,724.49

(South Zone) X(Easting): 1,209,451.14 (South Zone) X(Easting): 4,130,409.51

Precision: 1/5,000 Agency: DCSO Proj: 0001 Date: 1993

Approx. O.C.S. 27 Geographic Position: Latitude: 43° 11' 10" Longitude: 123° 27' 54"

Approx. O.C.S. 83 Geographic Position: Latitude: 43° 11' 10" Longitude: 123° 27' 58"

Set: A 2 3/8" dia. brass cap on a 1 1/4" O.D. x 32"
iron pipe protruding 1" above ground and stamped:

Douglas County Surveyors Office

T27S

WC

R S25 S30 R

7 S36 S31 6

W W

SOUTH 226.7 FT

1993

Note: For further information contact the Douglas County Surveyors Office, Room 205 Douglas County Justice Building, Roseburg, OR 97470. Phone 440-4272. Douglas County Residents outside Roseburg calling area, dial toll free 1-800-477-0991.