OFFICE OF THE
DOUGLAS COUNTY SURVEYOR

Station: SE cor. T 28 S, R 6 W, Sec 21
Set By (Agency): DCSO
Date Set: 1967
Recovered By RS,SJF
Date Recovered July 20,1984
Recovered By
Date Recovered
Recovered By
Date Recovered

400300

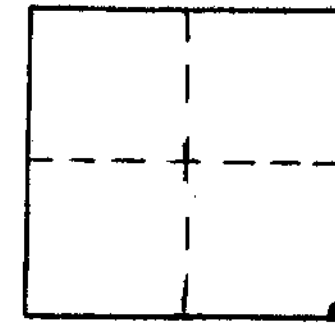

280-06W-21-003 28S 06W 21
SE CORNER

NAD	540424.01	4145904.68
83	43° 6'46"	123°24'16"

VERTICAL CONTROL

Elevation: NGS Line # USGS Line # OSHD Line #
Precision: Agency: Proj. # Date:

HORIZONTAL CONTROL OCS 27

South Zone State Plane Coordinates: Y(Northing) 540,459.20 X(Easting) 1,224,946.39
Precision: 1/5,000 Agency: DCSO Proj. # 0002 CS 59/45 Date: 1979
Approximate Geographic Position: Latitude 43°06'46" Longitude 123°24'12"

DESCRIPTION and TO REACH

A blue,river basalt, stone (originally described as 4x7x16 inches) protruding 4 inches from the ground and marked "CS" on east side. Also a DCSO disk stamped

T28S R6W
S21 | S22
S28 | S27
1967

on an iron pipe protruding 12 inches from the ground, firmly set but leaning west 3 inches from plumb.

TO REACH:

From the intersection of Winston Park Rd. (Co. Rd. #266) and Edgewood Street in T28S,R6W,Sec. 22 proceed southerly along Edgewood Street approximately 900 Ft. to monument on right . Monument lies 176 Ft. west of Edgewood Street, behind a house and at a corner of fences running south and west.

SKETCH

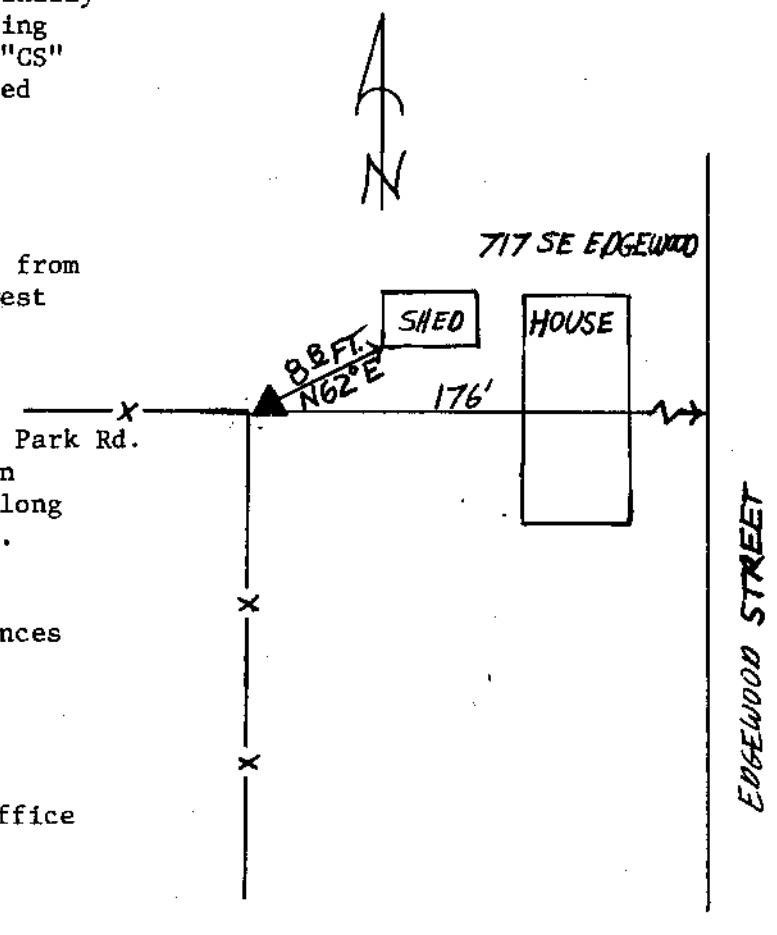

Reference Marks:

NOTE: See Douglas County Surveyors Office corner renewal records.

Note: For further information, contact the Douglas County Surveyor's Office, Room 205 Douglas County Justice Building, Roseburg, OR 97470. Phone 440-4278. Douglas County residents outside the Roseburg calling area, dial toll free 1-800-452-0991.