OFFICE OF THE
DOUGLAS COUNTY SURVEYOR

Station: SW Cor. T 30 S, R 5 W, Sec 29

Set By (Agency): D.C.S.O.

Date Set: 1979

Recovered By RS,SJF

Date Recovered June 4,1984

Recovered By

Date Recovered

Recovered By

Date Recovered

200200

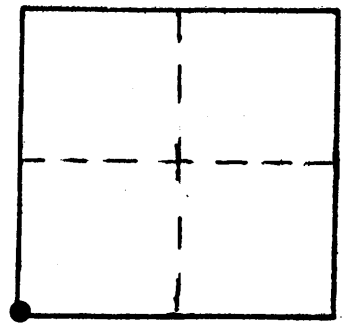

300-05W-29-013 30S 05W 29
SW CORNER

NAD	472005.15	4164726.11
83	42°55'36"	123°19'31"

VERTICAL CONTROL

Elevation: _____ NGS Line # _____ USGS Line # _____ OSHD Line # _____

Precision: _____ Agency: _____ Proj. # _____ Date: _____

HORIZONTAL CONTROL

OCS 27

South Zone State Plane Coordinates: Y(Northing) 472,041.00 X(Easting) 1,243,767.49

Precision: 1/5,000 Agency: D.C.S.O. Proj. # 6009-8 CS61/3 Date: 1979

Approximate Geographic Position: Latitude 42°55'37" Longitude 123°19'27"

DESCRIPTION and TO REACH

A D.C.S.O. disk on a 1 inch iron pipe stamped T30S R5W S30 | S29 1979 firmly set
S31 | S32
and protruding 1 inch above the ground.

TO REACH:

From the intersection of Ash Creek Road (Co. Rd. #299) an Canyonville-Riddle Road (Co. Rd. #21) in T30S,R5W,Sec. 30, proceed easterly along Co. Rd. #21 approximately 0.7 miles to a private road on the left, proceed northwesterly along private road approximately 0.2 miles to end of road and a house. Monument is approximately 250 feet west along an old east-west fenceline.

* See Douglas County Surveyor's Office corner renewal records.

SKETCH

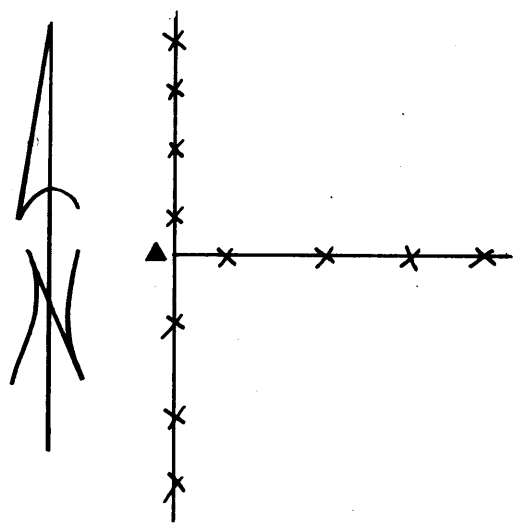

Reference Marks:

Note: For further information, contact the Douglas County Surveyor's Office, Room 205 Douglas County Justice Building, Roseburg, OR 97470. Phone 440-4278. Douglas County residents outside the Roseburg calling area, dial toll free 1-800-452-0991.