
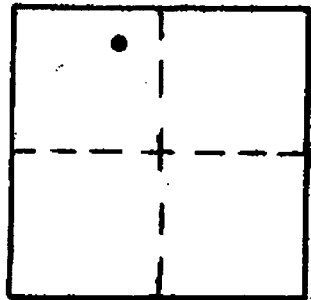


OFFICE OF THE  
DOUGLAS COUNTY SURVEYOR

Station: A-20 T 28 S, R 5 E, Sec 25  
Set By (Agency): BPR  
Date Set: 1956  
Recovered By USFS  
Date Recovered 1971  
Recovered By FLI (DCSO)  
Date Recovered 7-25-84  
Recovered By \_\_\_\_\_  
Date Recovered \_\_\_\_\_

UNS

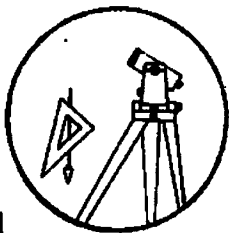

A-007

VERTICAL CONTROL NGVD 29 CORCON 6 NAVD 88 5363.312 FT

Elevation: 5358.847 NGS Line # 128 USGS Line # \_\_\_\_\_ OSHD Line # \_\_\_\_\_  
Precision: 2nd Agency: USC & GS Proj. # 2004-8 CS57/23 Date: 1957

HORIZONTAL CONTROL

South Zone State Plane Coordinates: Y(Northing) \_\_\_\_\_ X(Easting) \_\_\_\_\_  
Precision: \_\_\_\_\_ Agency: \_\_\_\_\_ Proj. # \_\_\_\_\_ Date: \_\_\_\_\_  
Approximate Geographic Position: Latitude \_\_\_\_\_ Longitude \_\_\_\_\_

DESCRIPTION and TO REACH

SKETCH

0.5 miles NE along Highway  
230 from USFS Road No. 3703 (Formerly  
284).

Brass cap in concrete post,  
52 ft. NW of edge of pavement. Near  
Highway stationing 1122+00.

Reference Marks:

Note: For further information, contact the Douglas County Surveyor's Office, Room 205  
Douglas County Justice Building, Roseburg, OR 97470. Phone 440-4278. Douglas  
County residents outside the Roseburg calling area, dial toll free 1-800-452-0991.