

2/82


9-035
BAXTER

243 5w 35

B-035

OFFICE OF THE
DOUGLAS COUNTY SURVEYOR

43° 43' 39" E 223.30
43° 26' 17" 123° 15' 07"

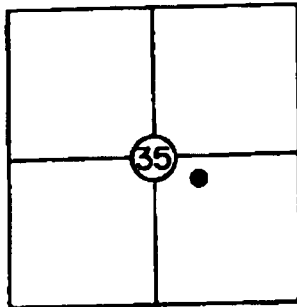

T 24 S, R 5 W, Sec. 35

Station: BAXTER

Set By (Agency): DCSO

Date: 1980

CORPCON 6 NAVD 88
519.664 FT

VERTICAL CONTROL

Elevation: 516.161 NGS(USC&GS) Line # _____ USGS Line # _____

Order (Calapooya)
Of Precision 2nd-I Agency: DCSO Proj. #: 2006 Date: 1981

HORIZONTAL CONTROL

Oregon State Plane Coordinates: Y(Northing) 657,590.20 X(Easting) 1,269,202.77
(South Zone)

Order (Calapooya)
Of Precision 1/25,000 Agency: DCSO Proj. #: 2006 Date: 1981

Approximate Geographic Position: Latitude= 43° 26' 17" Longitude= 123° 15' 07"

DESCRIPTION: A standard DCSO brass cap set in
a conc. filled belltile 6"x40" buried 39 in.

in ground stamped "BAXTER 1980" 3.0 ft. East of
fence R/W. 38.0 ft. West of edge of pavement

Co. Rd. #22. Approx. 381 ft. SW of intersection

Co. Rd. #22 and #22A. 1 ft. above pavement.

TO REACH: From intersection of Hwy 99 and

Oak St. in Oakland proceed NE on Oak St. (turns

to Driver Valley, Co. Rd. #22) 2.7 mi. to

monument on left,

A DCSO disk stamped "BAXTER RM 1 1980" bears
N 63° 43' 39" E 223.30 (grid)

A DCSO disk stamped "BAXTER RM-2 1980" bears S 17° 59' 23" W 103.80 (grid)

NOTE: For Possible Further Information On This Station, Please Contact The Douglas
County Surveyors Office, Rm. 205 Douglas County Justice Bldg., Roseburg, OR.
97470 Phone 672-3311 Ext. 272. Douglas County residents outside the
Roseburg calling area dial toll free 1-800-452-0991.

SKETCH

