


OFFICE OF THE
DOUGLAS COUNTY SURVEYOR

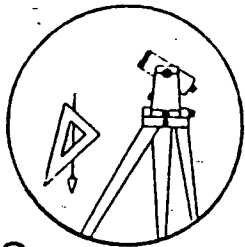


B-143

Station: BM 38
 Date Set: ?
 Set By (Agency): ?
 Date Recovered: 8-18-94
 Recovered By: RWS SJF

T 23 S, R 5, Sec 3

- | | |
|---|---|
| <input checked="" type="checkbox"/> Found | <input checked="" type="checkbox"/> New |
| <input type="checkbox"/> Reset | <input type="checkbox"/> Not Found |
| <input type="checkbox"/> Referenced | <input type="checkbox"/> Destroyed |

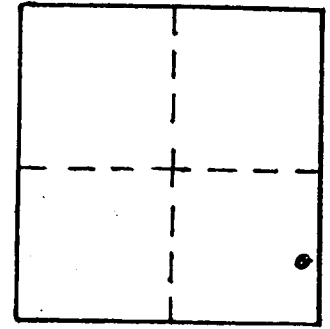

VERTICAL CONTROL

Elevation: 362.26 NGS Line # _____ USGS Line # _____ OSHD Line # _____
 Precision: -3rd Agency: DCSO Proj. # 2007 Date: 1994

HORIZONTAL CONTROL CORPSCON6 NAVD88 365.86 FT. CS 66/54

South Zone O.C.S. 27: Y(Northing) _____ X(Easting) _____

South Zone O.C.S. 83: Y(Northing) 714633 X(Easting) 4188176

Precision: GIS SCALED Agency: DCSO Proj. # _____ Date: 2014

Approx. Geographic Position: Latitude 43°35'40" Longitude 123°16'00"

DESCRIPTION and TO REACH

BOAT SPIKE WITH WASHER IN NORTH WEST
CORNER OF CONCRETE BRIDGE ABUTMENT,
STAMPED "38".

FROM THE INTERSECTION OF EAGLE VALLEY RD
(CO. RD # 389 FORMERLY STATE HWY 99) AND
ELK HEAD RD (CO. RD # 7) IN T23S R5W SEC 3,
PROCEED EASTERLY ALONG ELK HEAD RD APPROX.
0.65 MILES TO BRIDGE OVER SMALL CREEK
AND BOAT SPIKE IN NORTH WEST CORNER.

Reference Marks:

