

OFFICE OF THE
DOUGLAS COUNTY SURVEYOR

Station: BREANNE

T 26 S, R 4W, Sec 18



Date Set: 1999

Set By (Agency): DCSO

Date Recovered: 5-20-99

Recovered By: RWS SJF

- | | |
|-------------------------------------|---|
| <input type="checkbox"/> Found | <input checked="" type="checkbox"/> New |
| <input type="checkbox"/> Reset | <input type="checkbox"/> Not Found |
| <input type="checkbox"/> Referenced | <input type="checkbox"/> Destroyed |

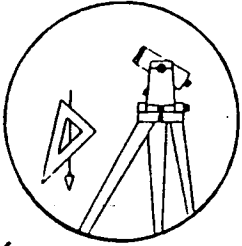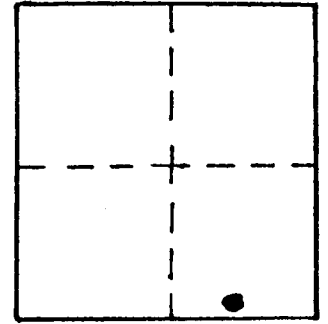

70' B-153

VERTICAL CONTROL

Elevation: 695.13 NGS Line # _____ USGS Line # _____ OSHD Line # _____

Precision: 3rd Agency: DCSO Proj. # 2007 Date: 1999

HORIZONTAL CONTROL CORPSCON6 NAVDB8 698.65 FT. CS 66/37

South Zone O.C.S. 27: Y(Northing) _____ X(Easting) _____

South Zone O.C.S. 83: Y(Northing) 607468 X(Easting) 4199718

Precision: GIS SCALED Agency: DCSO Proj. # _____ Date: 2014

Approx. NAD 83 Geographic Position: Latitude 43° 18' 06" Longitude 123° 12' 36"

DESCRIPTION and TO REACH

DCSO DRILL CAP SET IN CENTER OF A
3 FT DIA BOULDER SAMPLED "BREANNE 1999"

FROM THE INTERSECTION OF WHISTLER PARK RD
(CO. RD 244) AND SOUTH BANK RD IN
T 26 S R 4W SEC. 18, PROCEED SOUTHERLY ALONG
SOUTH BANK ROAD 0.5 MILES TO POND AND
MONUMENT ON LEFT

Reference Marks:

