


C-004

OFFICE OF THE
DOUGLAS COUNTY SURVEYOR

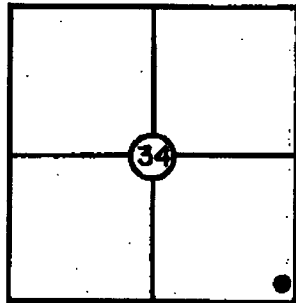

T 21 S, R 12 W, Sec. 34

Station: C-56

Set By (Agency): USC & GS

Date: 1930

VERTICAL CONTROL

CORCON NAVD 88
16.359 FT

Elevation: 12,776 NGS(USC&GS) Line # 73 USGS Line # _____

Order
Of Precision 2nd Agency: DCSO Proj. #: 2006 Date: 1973
(1947)

HORIZONTAL CONTROL

Oregon State Plane Coordinates: Y(Northing) _____ X(Easting) _____
(South Zone)

Order
Of Precision _____ Agency: _____ Proj. #: _____ Date: _____

Approximate Geographic Position: Latitude= _____ Longitude= _____

DESCRIPTION: From Reedsport Post office

proceed s'thly across Hwy. 38 on 3rd St. 0.05 mi.

to intersection, go right on Winchester Ave.

0.60 mi. to station. It lies approx. 80 ft.

w'stly on Winch. Ave. from Holly Court &


approx 120 ft. back e'stly of Scholfield Drive.

It is a brasscap set in concrete & lies approx

2 ft. right of P.P. # AE 34R.

VICINITY: Reedsport - Winchester Ave.

SKETCH

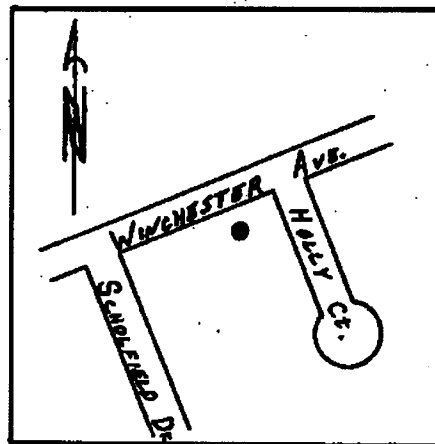

NOTE: For Possible Further Information On This Station, Please Contact The Douglas County Surveyors Office, Rm. 205 Douglas County Justice Bldg., Roseburg, OR. 97470 Phone 672-3311 Ext. 272.. Douglas County residents outside the Roseburg calling area dial toll free 1-800-452-0991.