


OFFICE OF THE

c-053
C-666

245 5W 5

DOUGLAS COUNTY SURVEYOR

NAD 685412.57 4174718.62
83 43°30'47" 123°18'54"

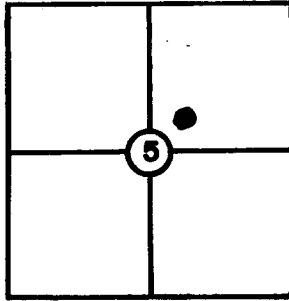

T 24 S, R 5W, Sec. 5

Station: C-666

Set By (Agency): OSHD

Date: 1975

*CORPCOM 6 NAVD 88
627.346 FT*

VERTICAL CONTROL

NGVD 29

Elevation: 623.78 NGS(USC&GS) Line # _____ U96S Line # 369

Order Of Precision 3rd Agency: OSHD Proj. #: _____ Date: 1956

HORIZONTAL CONTROL

OLS 27

Oregon State Plane Coordinates: Y(Northing) 685,446.93 X(Easting) 1,253,758.79
(South Zone)

Order Of Precision 1/25,000 Agency: DCSO Proj. #: 2004-4 Date: 1974


Approximate Geographic Position: Latitude= 43°30'47" Longitude= 123°18'49"

DESCRIPTION: Station is OSHD bronze disk
set in concrete bridge cap is not stamped
but is center punched.

To reach the sta. from Roseburg proceed
N. on I-5 approx. 25 mi. to the Rice
Valley exit and the sta. in the SE Cor. of
the bridge.

VICINITY: Rice Valley exit off I-5.

SKETCH

 

NOTE: For Possible Further Information On This Station, Please Contact The Douglas County Surveyors Office, Rm. 205 Douglas County Justice Bldg., Roseburg, OR. 97470 Phone 672-3311 Ext. 272.. Douglas County residents outside the Roseburg calling area dial toll free 1-800-452-0991.